



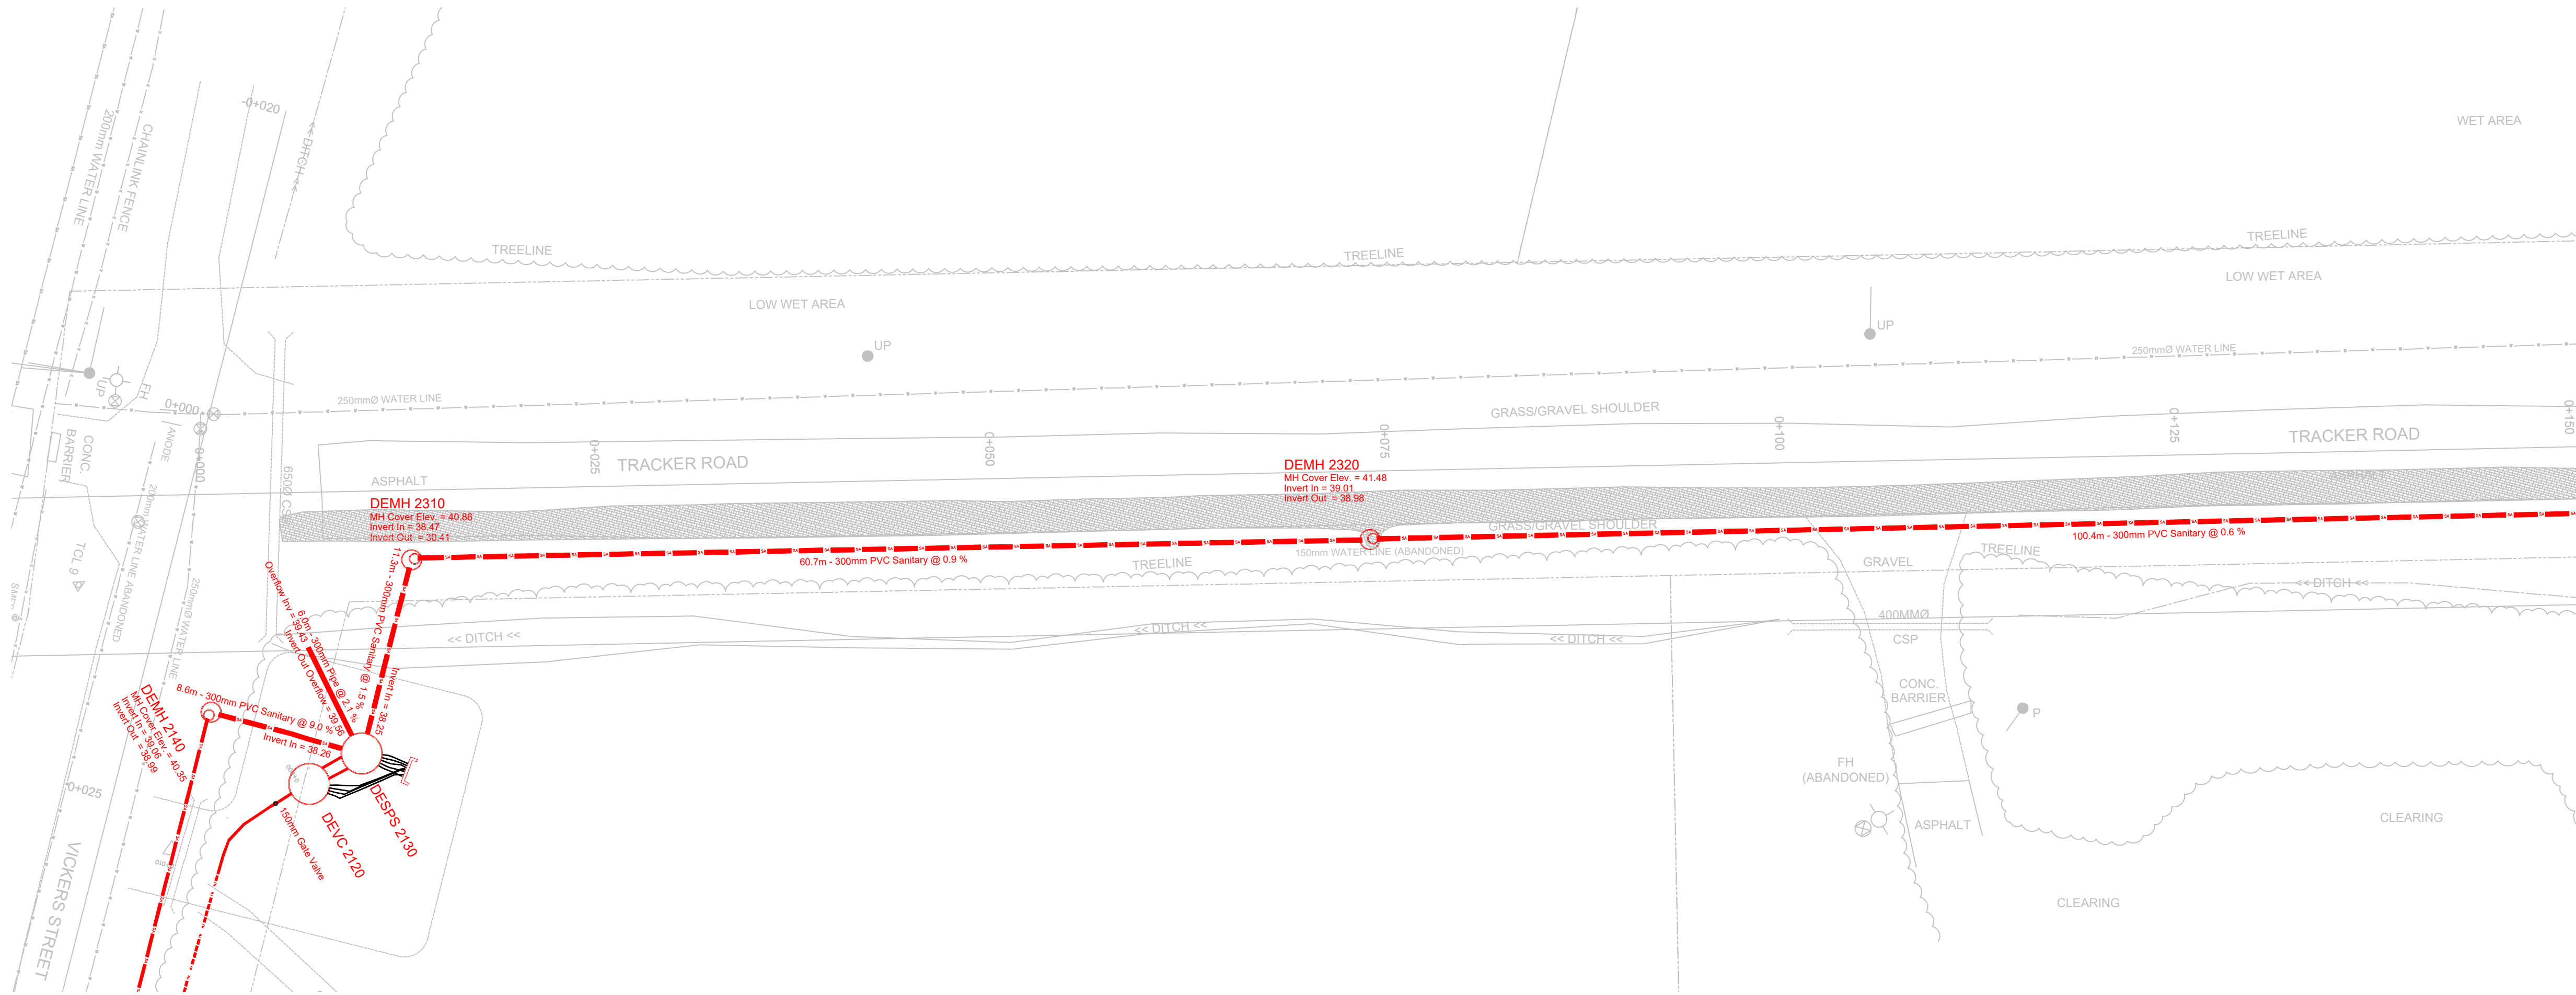

TRACKER ROAD PLAN - STA. 0+000 TO STA. 0+150

H = 1 : 250

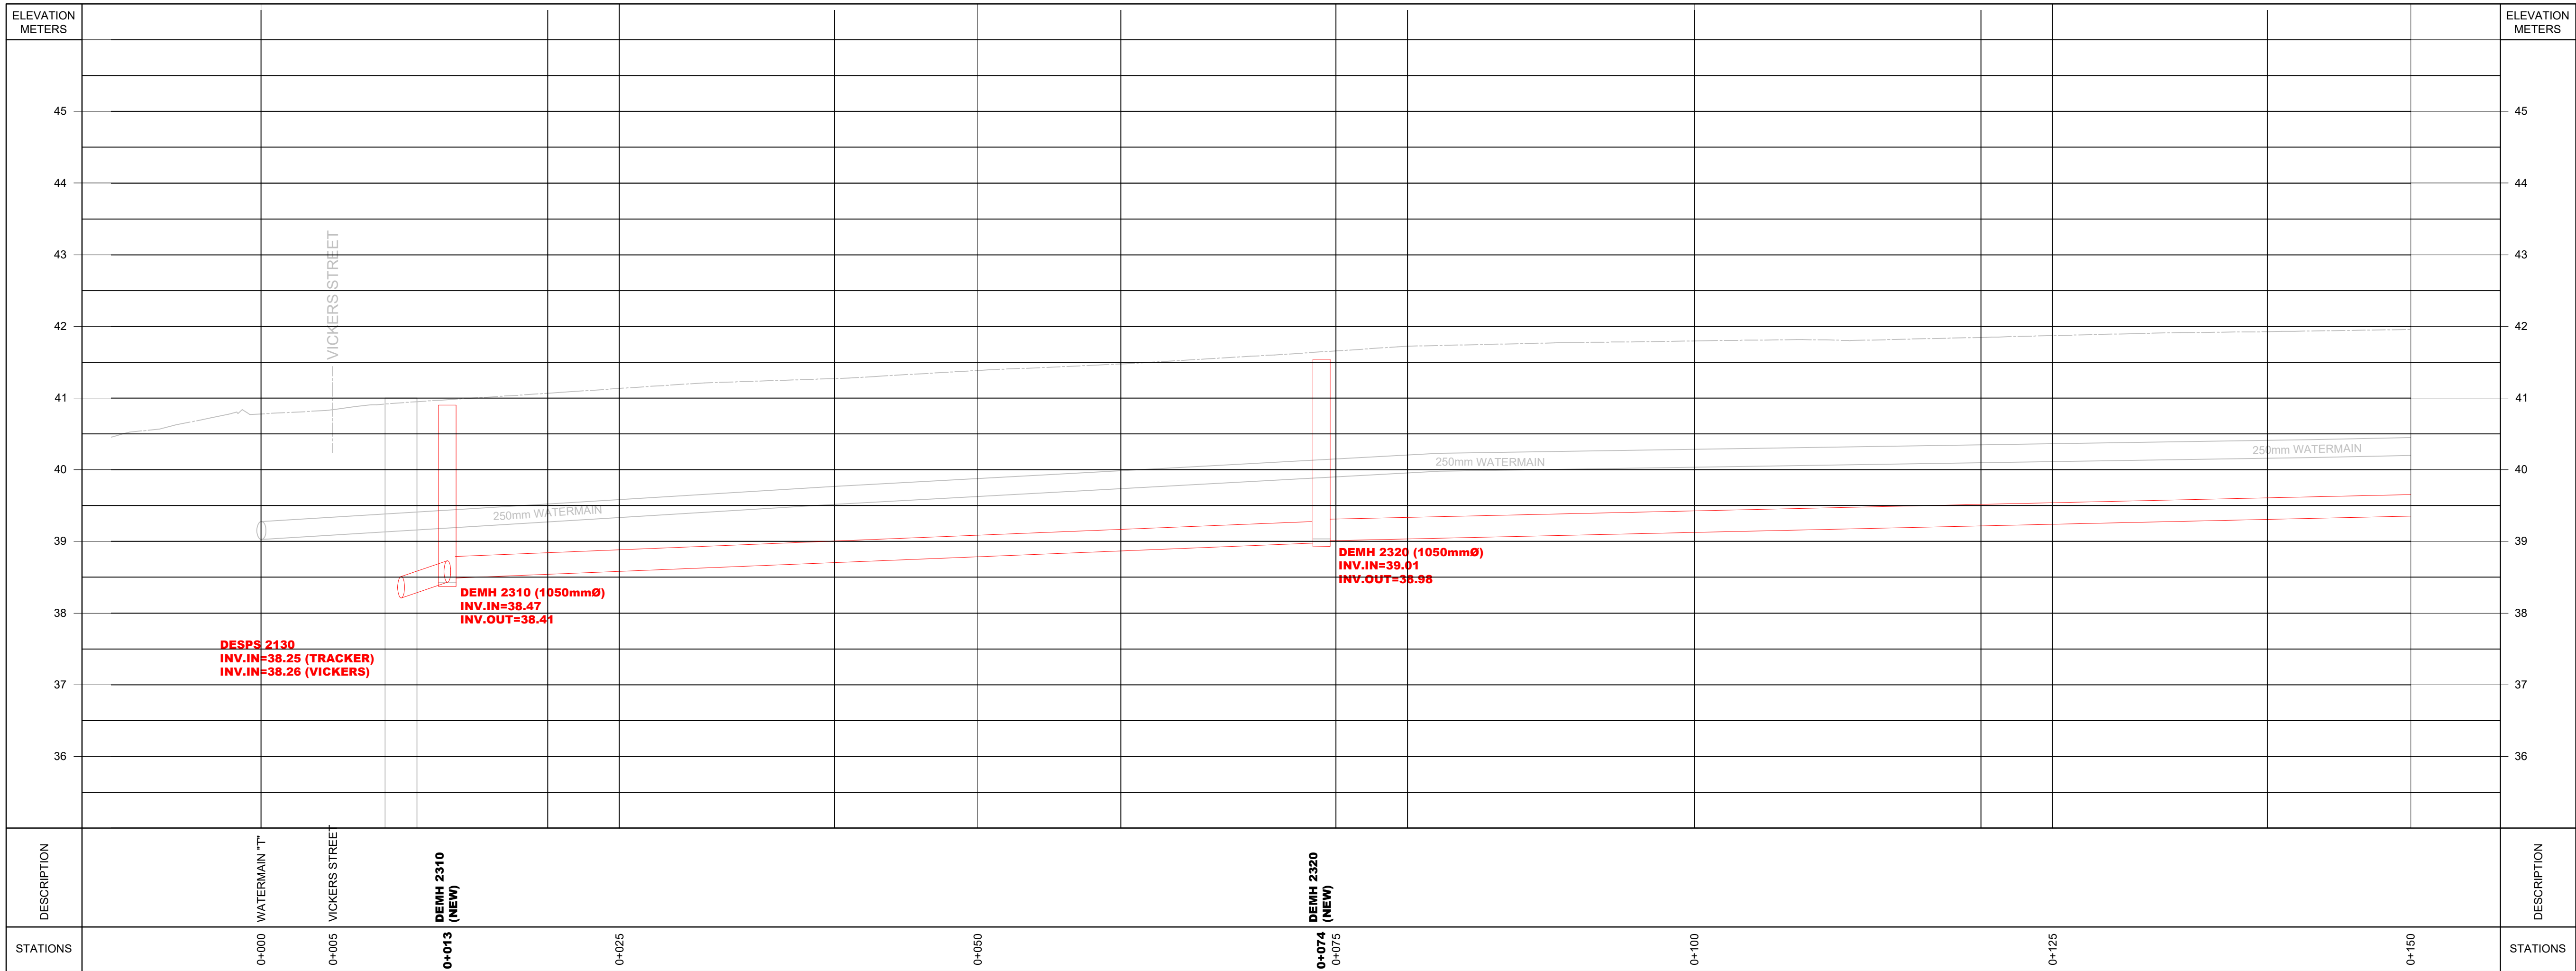

TRACKER ROAD PROFILE - STA. 0+000 TO STA. 0+150

H = 1 : 250
V = 1 : 50

General Notes

1. SURVEY PLAN PROVIDED BY THOMPSON CONN LIMITED.
— SURVEY CARRIED OUT DECEMBER 6 TO DECEMBER 22, 2021.
2. ALL REFERENCE POINTS ARE REFERRED TO NOVA SCOTIA COORDINATE MONUMENT #209547 ELEV. = 57.223. MAP PROJECTION: NOVA SCOTIA 3° MODIFIED MERCATOR PROJECTION, ZONE 5 (CENTRAL MERIDIAN 64°30'W) DATUM: ATS77. BENCHMARKS HAVE BEEN SET WHERE INDICATED.
3. EXISTING BURIED UTILITIES ARE SHOWN AS APPROXIMATE ONLY. LOCATIONS TO BE FIELD VERIFIED AS NECESSARY BY THE CONTRACTOR.
4. CONTRACTOR SHALL COORDINATE WITH N.S.P. FOR RELOCATION OF UTILITY POLES OR GUYS AS REQUIRED.
5. ALL DISTURBED AREAS MUST BE REINSTATED TO ORIGINAL CONDITION OR BETTER. ROAD ASPHALT TO BE MINIMUM 100mm THICK. PARKING LOT AND DRIVEWAY ASPHALT TO BE MINIMUM 50mm THICK. GRASSED AREAS TO BE REINSTATED WITH TOPSOIL AND SOD.
6. ALL STREET AND TRAFFIC SIGNAGE DISTURBED DURING CONSTRUCTION SHALL BE RESTORED AS SOON AS POSSIBLE AT THE SAME CHAINAGE LOCATION. APPROPRIATE TEMPORARY STREET AND TRAFFIC SIGNAGE SHALL BE MAINTAINED AT ALL LOCATIONS UNTIL SUCH TIME AS THE PERMANENT SIGNAGE IS RESTORED.
7. ANY INFRASTRUCTURE UNCOVERED DURING THE COURSE OF CONSTRUCTION SHALL BE SURVEYED AND INCLUDED IN THE RECORD/AS-BUILT INFORMATION AS PER SPECIFICATIONS.
8. ALL WORK SHALL BE CONSTRUCTED IN ACCORDANCE WITH THE NSDPW STANDARD SPECIFICATION, HIGHWAY CONSTRUCTION AND MAINTENANCE (LATEST EDITION).

2	PROFILE - EXISTING GRADE OVER NEW SANITARY	JULY 2023
1	ISSUED FOR TENDER	MAY 2023
No.	Revision/Issue	Date

MUNICIPALITY OF THE
COUNTY OF COLCHESTER


1 CHURCH STREET, PO BOX 697 TRURO NS B2N 5E7

AS-BUILTS

Project:	DEBERT SEWER - TRACKER & SPS (PROJECT NO. 2309-1480)
Drawing Title:	TRACKER ROAD PLAN & PROFILE STA. 0+000 TO STA. 0+150


Stamp:	Stamp:
--------	--------

Date:	FEB 2025	Dwg. No.:	C-01
Drawn/Chkd.:	TB / CM		
Scale:	AS NOTED		

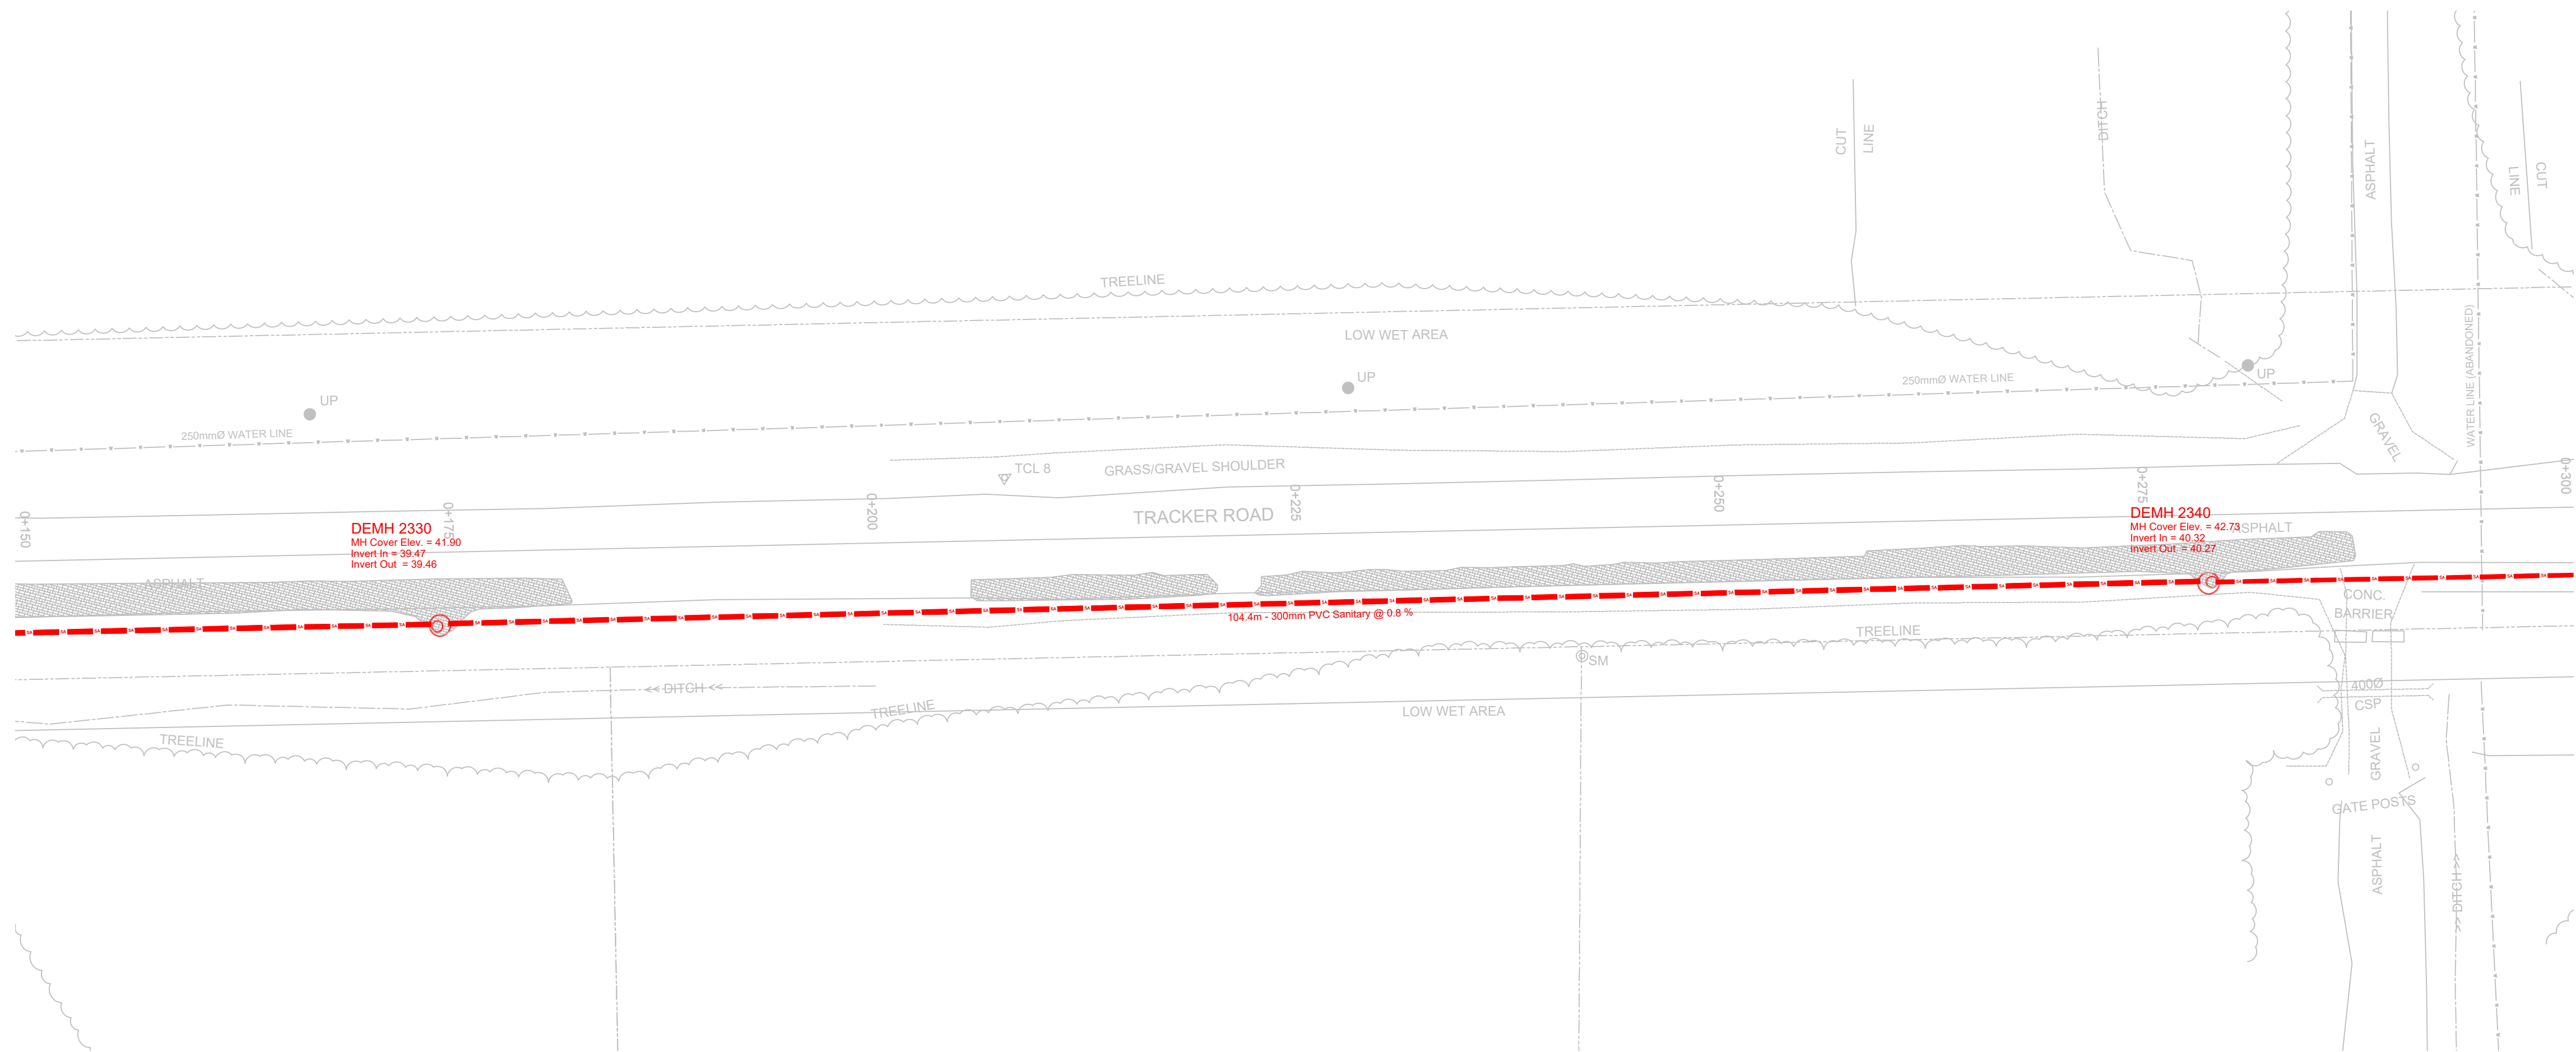

TRACKER ROAD PLAN - STA. 0+150 TO STA. 0+300

H = 1 : 250

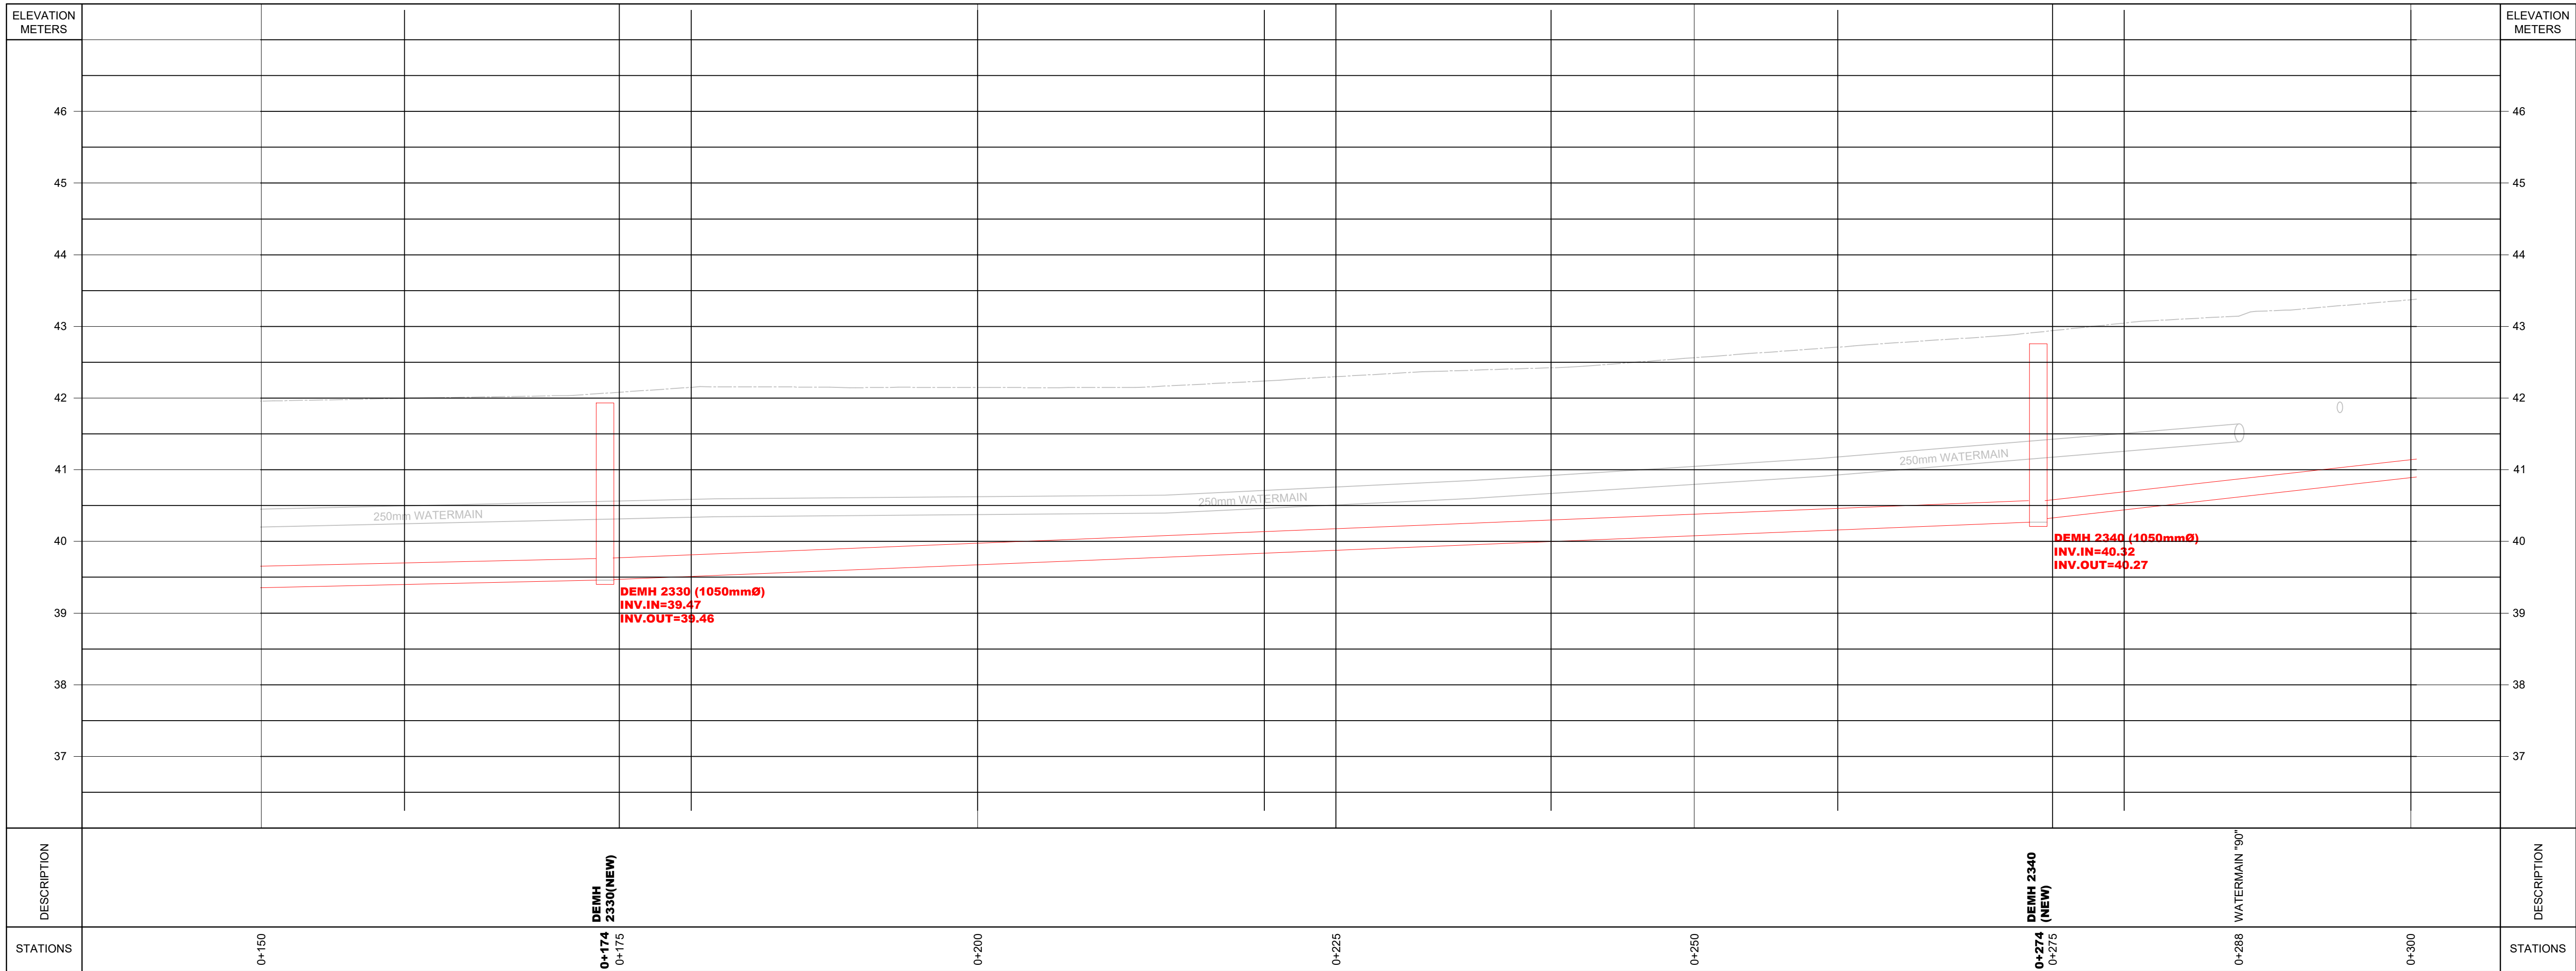

TRACKER ROAD PROFILE - STA. 0+150 TO STA. 0+300

H = 1 : 250
V = 1 : 50

General Notes

1. SURVEY PLAN PROVIDED BY THOMPSON CONN LIMITED.
- SURVEY CARRIED OUT DECEMBER 6 TO DECEMBER 22, 2021.
2. ALL REFERENCE POINTS ARE REFERRED TO NOVA SCOTIA COORDINATE MONUMENT #209547 ELEV. = 57.223. MAP PROJECTION: NOVA SCOTIA 3' MODIFIED MERCATOR PROJECTION, ZONE 5 (CENTRAL MERIDIAN 64°30'W) DATUM: ATSS77. BENCHMARKS HAVE BEEN SET WHERE INDICATED.
3. EXISTING BURIED UTILITIES ARE SHOWN AS APPROXIMATE ONLY. LOCATIONS TO BE FIELD VERIFIED AS NECESSARY BY THE CONTRACTOR.
4. CONTRACTOR SHALL COORDINATE WITH N.S.P. FOR RELOCATION OF UTILITY POLES OR GUYS AS REQUIRED.
5. ALL DISTURBED AREAS MUST BE REINSTATED TO ORIGINAL CONDITION OR BETTER. ROAD ASPHALT TO BE MINIMUM 100mm THICK. PARKING LOT AND DRIVEWAY ASPHALT TO BE MINIMUM 50mm THICK. GRASSED AREAS TO BE REINSTATED WITH TOPSOIL AND SOD.
6. ALL STREET AND TRAFFIC SIGNAGE DISTURBED DURING CONSTRUCTION SHALL BE RESTORED AS SOON AS POSSIBLE AT THE SAME CHAINAGE LOCATION. APPROPRIATE TEMPORARY STREET AND TRAFFIC SIGNAGE SHALL BE MAINTAINED AT ALL LOCATIONS UNTIL SUCH TIME AS THE PERMANENT SIGNAGE IS RESTORED.
7. ANY INFRASTRUCTURE UNCOVERED DURING THE COURSE OF CONSTRUCTION SHALL BE SURVEYED AND INCLUDED IN THE RECORD/AS-BUILT INFORMATION AS PER SPECIFICATIONS.
8. ALL WORK SHALL BE CONSTRUCTED IN ACCORDANCE WITH THE NSDPW STANDARD SPECIFICATION, HIGHWAY CONSTRUCTION AND MAINTENANCE (LATEST EDITION).

2	PROFILE - EXISTING GRADE OVER NEW SANITARY	JULY 2023
1	ISSUED FOR TENDER	MAY 2023
No.	Revision/Issue	Date

MUNICIPALITY OF THE
COUNTY OF COLCHESTER

1 CHURCH STREET, PO BOX 697 TRURO NS B2N 5E7


AS-BUILTS

Project:
DEBERT SEWER - TRACKER & SPS
(PROJECT NO. 2309-1480)

Drawing Title:
TRACKER ROAD
PLAN & PROFILE
STA. 0+150 TO STA. 0+300


Stamp:	Stamp:

Date:	FEB 2025	Dwg. No.:
Drawn/Checked:	TB / CM	C-02
Scale:	AS NOTED	

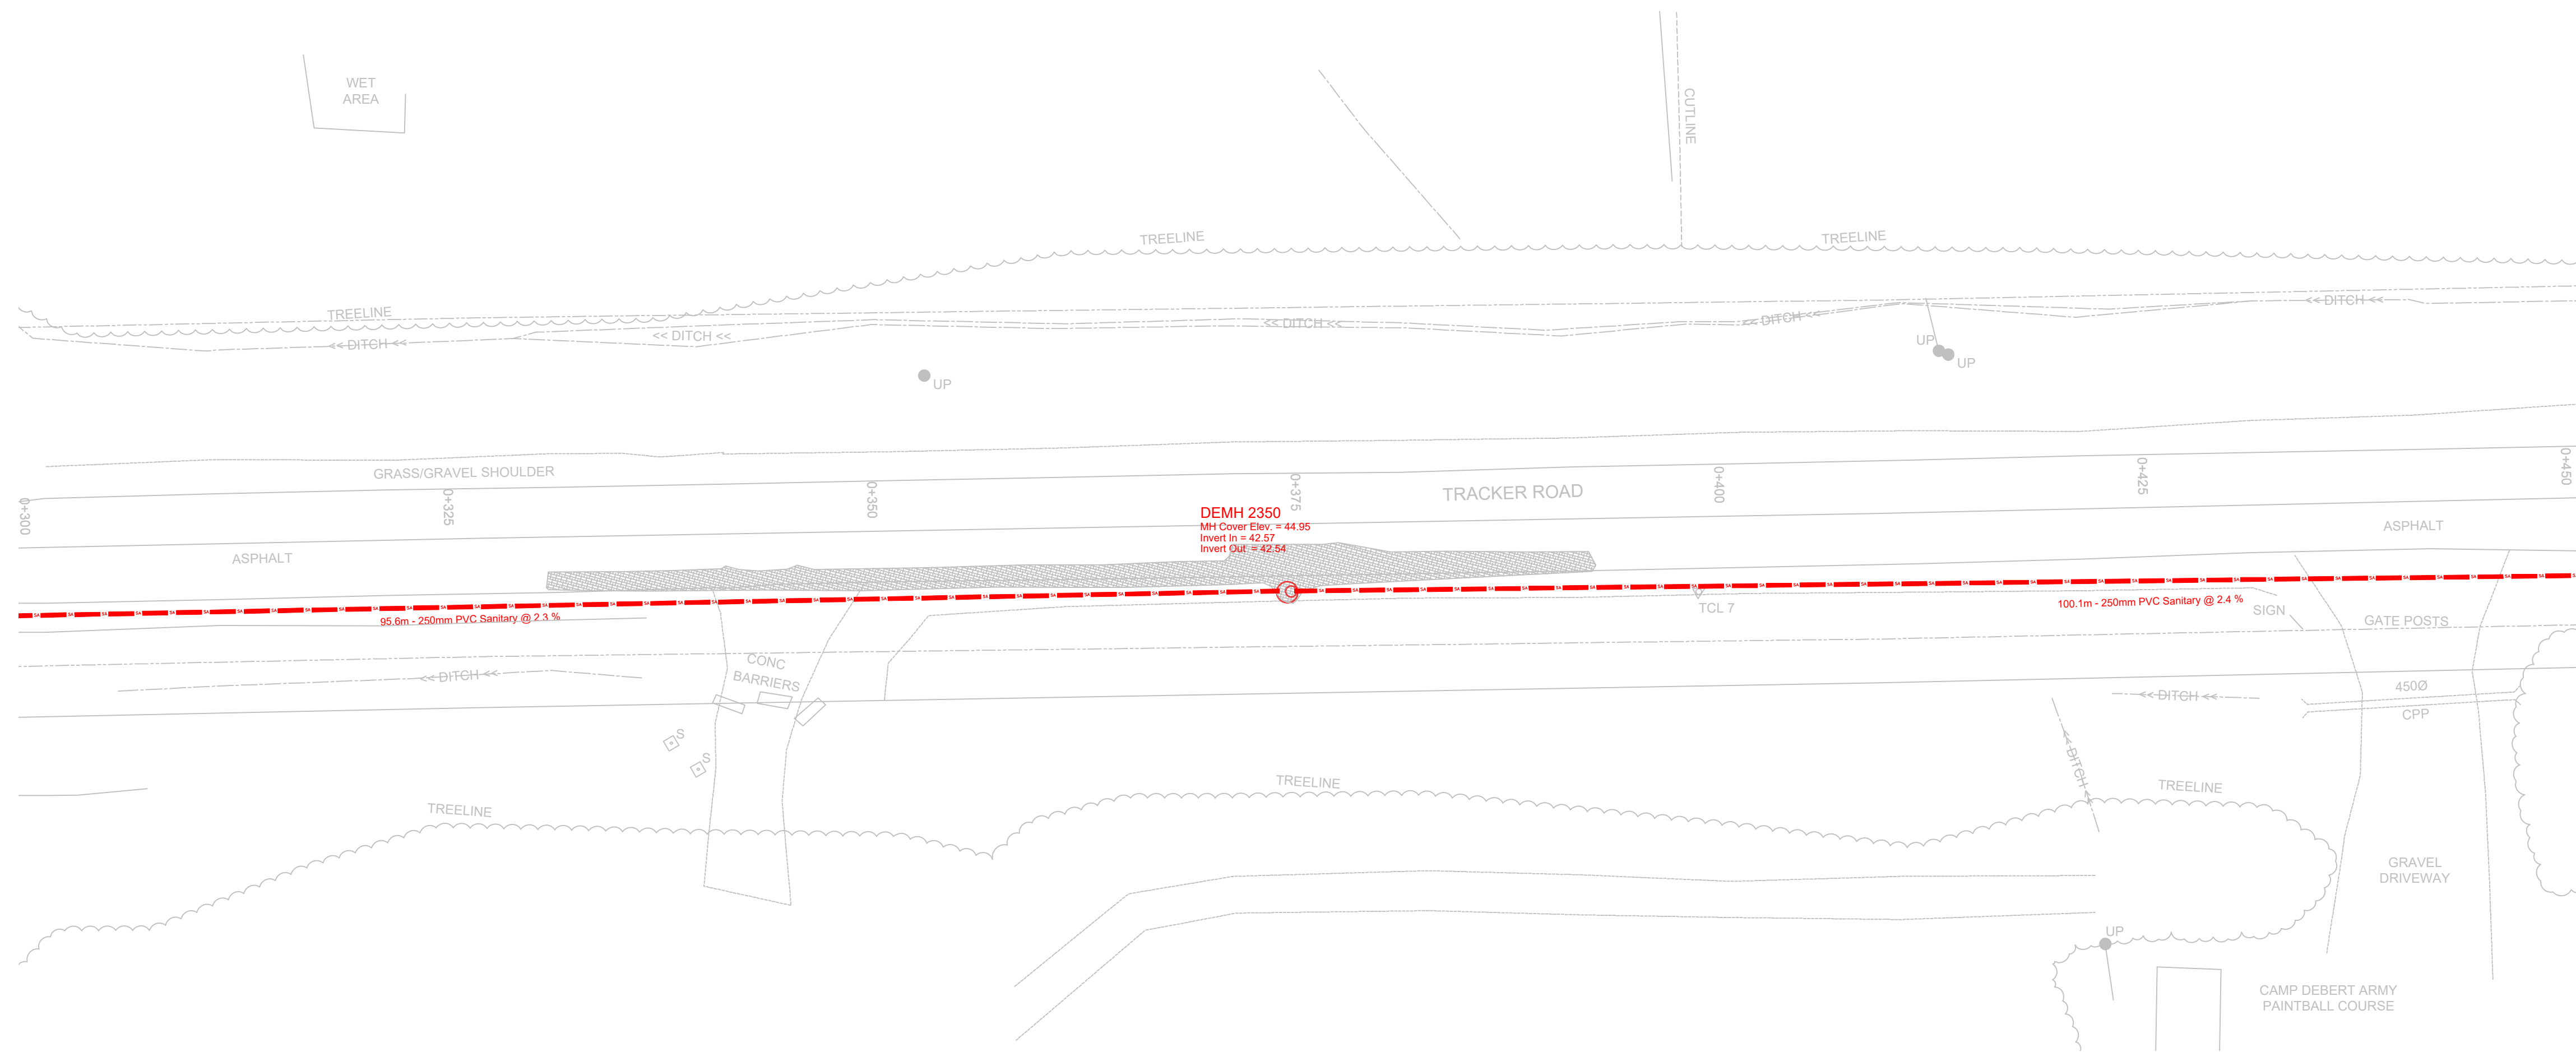

TRACKER ROAD PLAN - STA. 0+300 TO STA. 0+450

H = 1 : 250

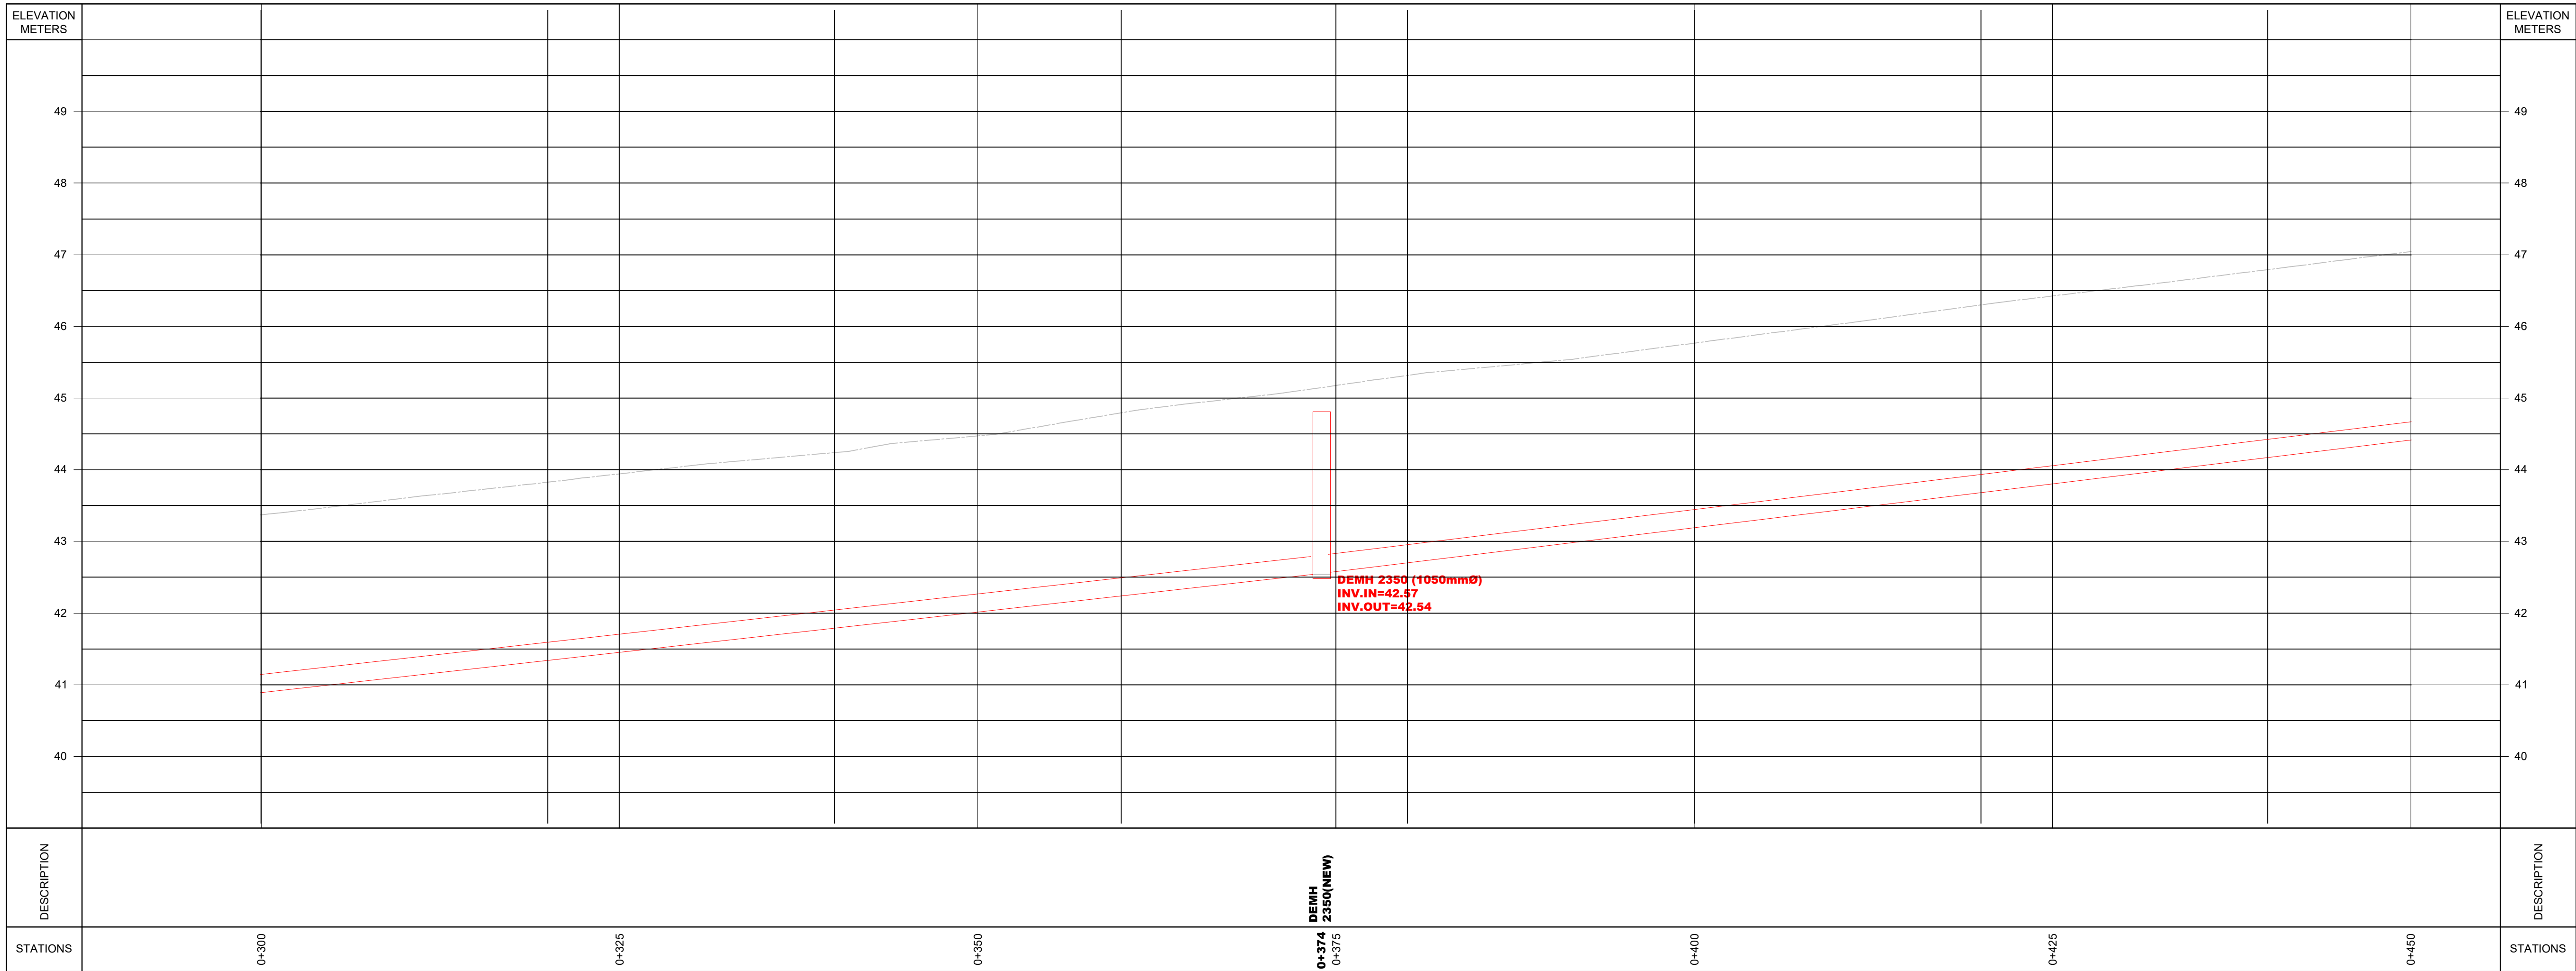

TRACKER ROAD PROFILE - STA. 0+300 TO STA. 0+450

H = 1 : 250
V = 1 : 50

General Notes

1. SURVEY PLAN PROVIDED BY THOMPSON CONN LIMITED.
- SURVEY CARRIED OUT DECEMBER 6 TO DECEMBER 22, 2021.
2. ALL REFERENCE POINTS ARE REFERRED TO NOVA SCOTIA COORDINATE MONUMENT #209547 ELEV. = 57.223. MAP PROJECTION: NOVA SCOTIA 3' MODIFIED MERCATOR PROJECTION, ZONE 5 (CENTRAL MERIDIAN 64°30'W) DATUM: ATSS77. BENCHMARKS HAVE BEEN SET WHERE INDICATED.
3. EXISTING BURIED UTILITIES ARE SHOWN AS APPROXIMATE ONLY. LOCATIONS TO BE FIELD VERIFIED AS NECESSARY BY THE CONTRACTOR.
4. CONTRACTOR SHALL COORDINATE WITH N.S.P. FOR RELOCATION OF UTILITY POLES OR GUYS AS REQUIRED.
5. ALL DISTURBED AREAS MUST BE REINSTATED TO ORIGINAL CONDITION OR BETTER. ROAD ASPHALT TO BE MINIMUM 100mm THICK. PARKING LOT AND DRIVEWAY ASPHALT TO BE MINIMUM 50mm THICK. GRASSED AREAS TO BE REINSTATED WITH TOPSOIL AND SOD.
6. ALL STREET AND TRAFFIC SIGNAGE DISTURBED DURING CONSTRUCTION SHALL BE RESTORED AS SOON AS POSSIBLE AT THE SAME CHAINAGE LOCATION. APPROPRIATE TEMPORARY STREET AND TRAFFIC SIGNAGE SHALL BE MAINTAINED AT ALL LOCATIONS UNTIL SUCH TIME AS THE PERMANENT SIGNAGE IS RESTORED.
7. ANY INFRASTRUCTURE UNCOVERED DURING THE COURSE OF CONSTRUCTION SHALL BE SURVEYED AND INCLUDED IN THE RECORD/AS-BUILT INFORMATION AS PER SPECIFICATIONS.
8. ALL WORK SHALL BE CONSTRUCTED IN ACCORDANCE WITH THE NSDPW STANDARD SPECIFICATION, HIGHWAY CONSTRUCTION AND MAINTENANCE (LATEST EDITION).

2	PROFILE - EXISTING GRADE OVER NEW SANITARY	JULY 2023
1	ISSUED FOR TENDER	MAY 2023
No.	Revision/Issue	Date

MUNICIPALITY OF THE
COUNTY OF COLCHESTER

1 CHURCH STREET, PO BOX 697 TRURO NS B2N 5E7


AS-BUILTS

Project:
DEBERT SEWER - TRACKER & SPS
(PROJECT NO. 2309-1480)

Drawing Title:
TRACKER ROAD
PLAN & PROFILE
STA. 0+300 TO STA. 0+450

Stamp:	Stamp:

Date:	FEB 2025	Dwg. No.:
Drawn/Checked:	TB / CM	C-03
Scale:	AS NOTED	

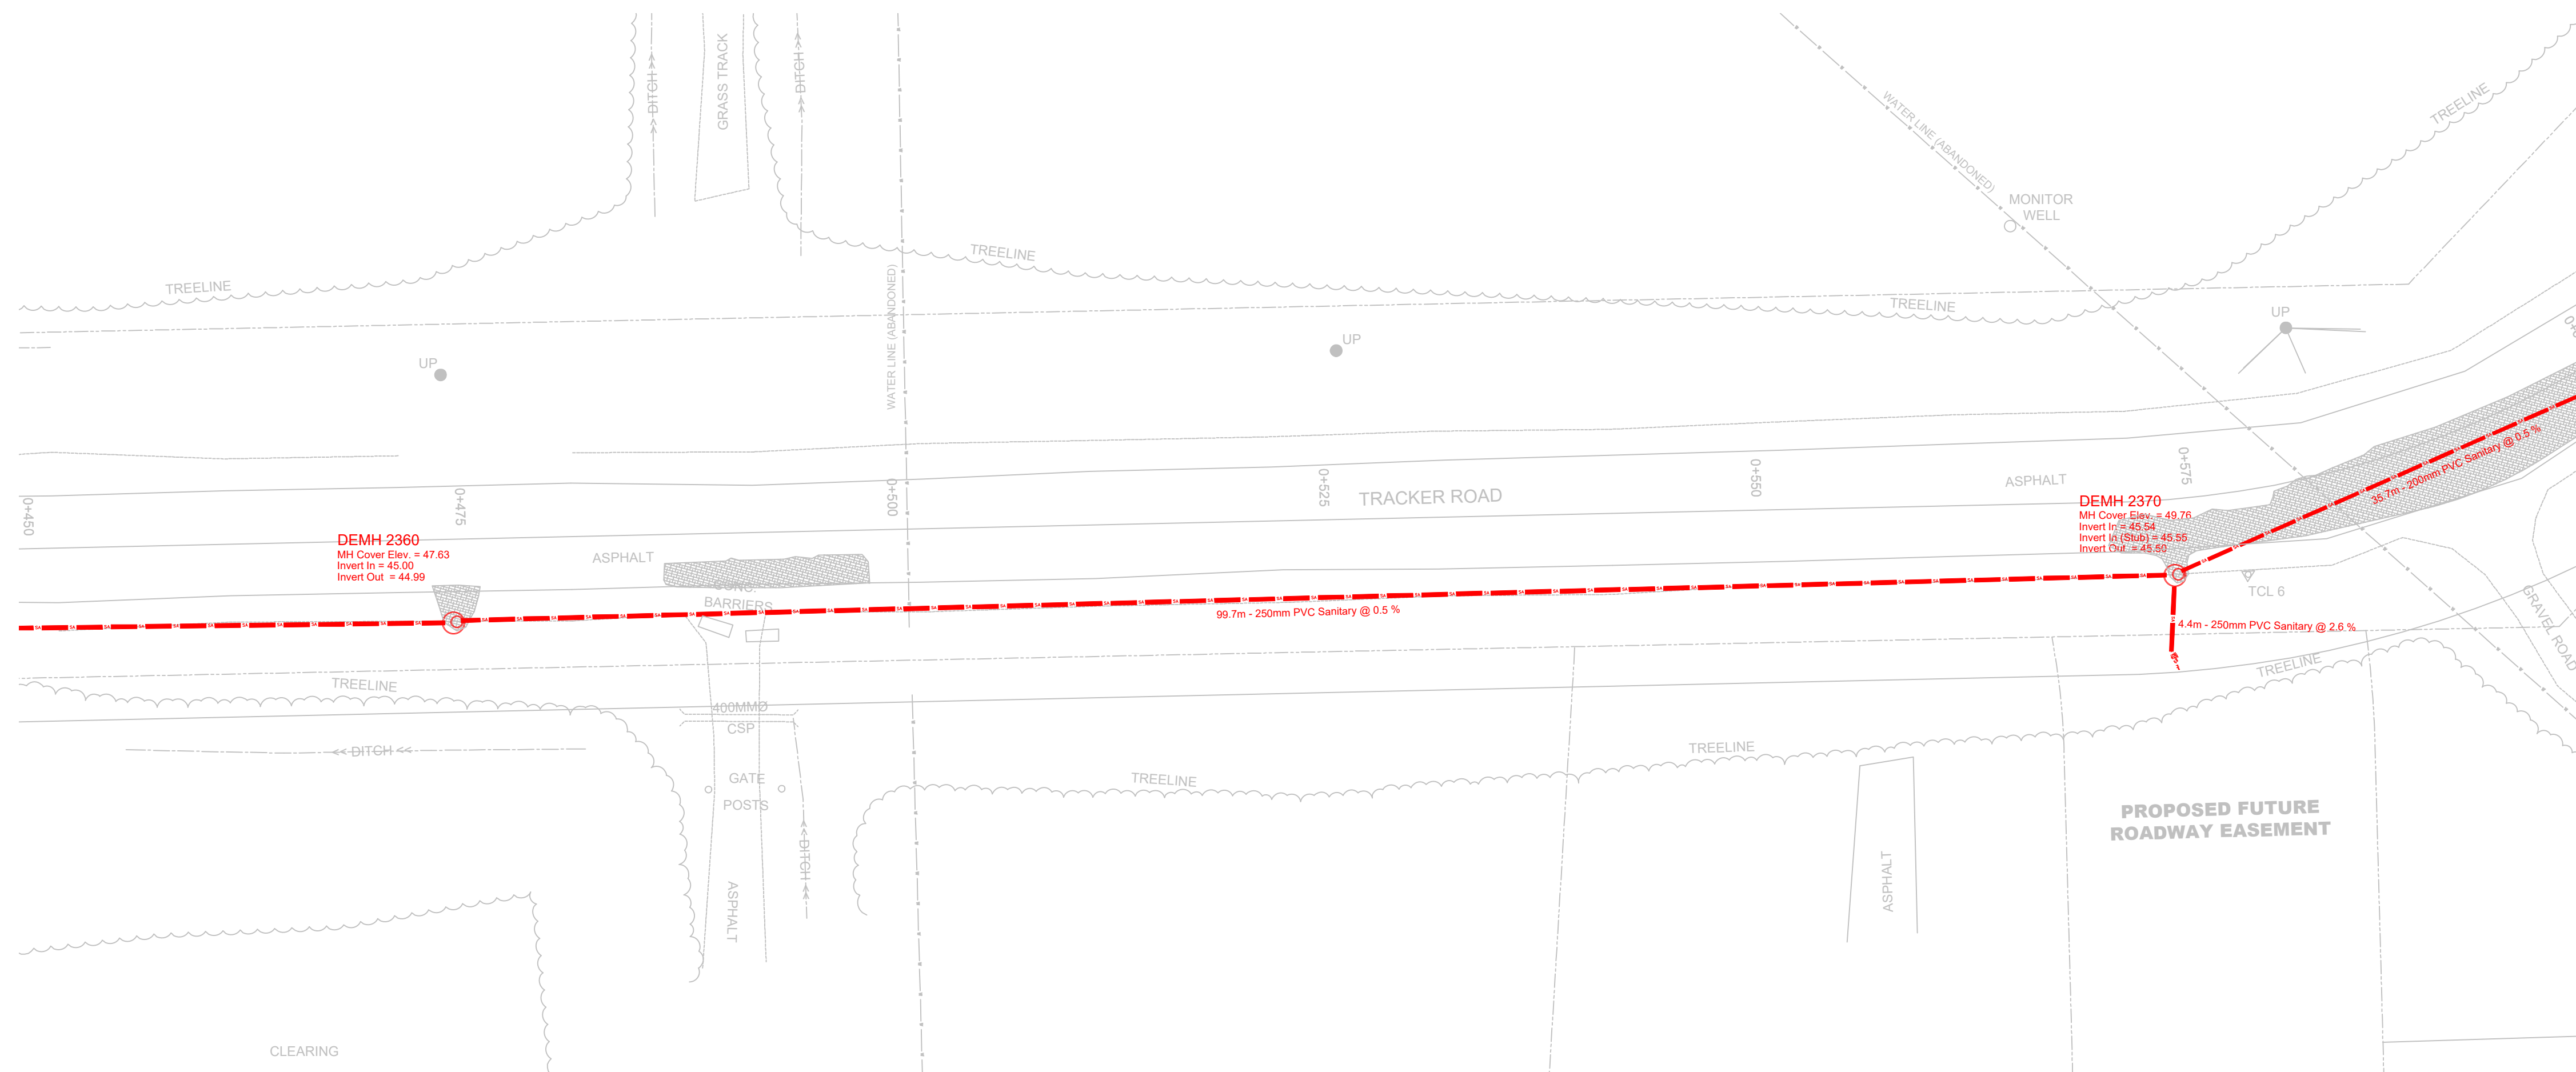

TRACKER ROAD PLAN - STA. 0+450 TO STA. 0+600

H = 1 : 250



TRACKER ROAD PROFILE - STA. 0+450 TO STA. 0+600

H = 1 : 250
V = 1 : 50

General Notes

1. SURVEY PLAN PROVIDED BY THOMPSON CONN LIMITED.
— SURVEY CARRIED OUT DECEMBER 6 TO DECEMBER 22, 2021.
2. ALL REFERENCE POINTS ARE REFERRED TO NOVA SCOTIA COORDINATE MONUMENT #209547 ELEV. = 57.223. MAP PROJECTION: NOVA SCOTIA 3° MODIFIED MERCATOR PROJECTION, ZONE 5 (CENTRAL MERIDIAN 64°30'W) DATUM: ATSS77. BENCHMARKS HAVE BEEN SET WHERE INDICATED.
3. EXISTING BURIED UTILITIES ARE SHOWN AS APPROXIMATE ONLY. LOCATIONS TO BE FIELD VERIFIED AS NECESSARY BY THE CONTRACTOR.
4. CONTRACTOR SHALL COORDINATE WITH N.S.P. FOR RELOCATION OF UTILITY POLES OR GUYS AS REQUIRED.
5. ALL DISTURBED AREAS MUST BE REINSTATED TO ORIGINAL CONDITION OR BETTER. ROAD ASPHALT TO BE MINIMUM 100mm THICK. PARKING LOT AND DRIVEWAY ASPHALT TO BE MINIMUM 50mm THICK. GRASSED AREAS TO BE REINSTATED WITH TOPSOIL AND SOD.
6. ALL STREET AND TRAFFIC SIGNAGE DISTURBED DURING CONSTRUCTION SHALL BE RESTORED AS SOON AS POSSIBLE AT THE SAME CHAINAGE LOCATION. APPROPRIATE TEMPORARY STREET AND TRAFFIC SIGNAGE SHALL BE MAINTAINED AT ALL LOCATIONS UNTIL SUCH TIME AS THE PERMANENT SIGNAGE IS RESTORED.
7. ANY INFRASTRUCTURE UNCOVERED DURING THE COURSE OF CONSTRUCTION SHALL BE SURVEYED AND INCLUDED IN THE RECORD/AS-BUILT INFORMATION AS PER SPECIFICATIONS.
8. ALL WORK SHALL BE CONSTRUCTED IN ACCORDANCE WITH THE NSDPW STANDARD SPECIFICATION, HIGHWAY CONSTRUCTION AND MAINTENANCE (LATEST EDITION).

2	PROFILE - EXISTING GRADE OVER NEW SANITARY	JULY 2023
1	ISSUED FOR TENDER	MAY 2023
No.	Revision/Issue	Date

MUNICIPALITY OF THE
COUNTY OF COLCHESTER

1 CHURCH STREET, PO BOX 697 TRURO NS B2N 5E7

AS-BUILTS

Project:	DEBERT SEWER - TRACKER & SPS (PROJECT NO. 2309-1480)
Drawing Title:	TRACKER ROAD PLAN & PROFILE STA. 0+450 TO STA. 0+600

Stamp:	Stamp:

Date:	FEB 2025	Dwg. No.:	C-04
Drawn/Checked:	TB / CM		
Scale:	AS NOTED		



TRACKER ROAD PLAN - STA. 0+600 TO STA. 0+725

H = 1 : 250



TRACKER ROAD PROFILE - STA. 0+600 TO STA. 0+725

H = 1 : 250
V = 1 : 50

General Notes

1. SURVEY PLAN PROVIDED BY THOMPSON CONN LIMITED.
— SURVEY CARRIED OUT DECEMBER 6 TO DECEMBER 22, 2021.
2. ALL REFERENCE POINTS ARE REFERRED TO NOVA SCOTIA COORDINATE MONUMENT #209547 ELEV. = 57.223. MAP PROJECTION: NOVA SCOTIA 3° MODIFIED MERCATOR PROJECTION, ZONE 5 (CENTRAL MERIDIAN 64°30'W) DATUM: ATS77. BENCHMARKS HAVE BEEN SET WHERE INDICATED.
3. EXISTING BURIED UTILITIES ARE SHOWN AS APPROXIMATE ONLY. LOCATIONS TO BE FIELD VERIFIED AS NECESSARY BY THE CONTRACTOR.
4. CONTRACTOR SHALL COORDINATE WITH N.S.P. FOR RELOCATION OF UTILITY POLES OR GUYS AS REQUIRED.
5. ALL DISTURBED AREAS MUST BE REINSTATED TO ORIGINAL CONDITION OR BETTER. ROAD ASPHALT TO BE MINIMUM 100mm THICK. PARKING LOT AND DRIVEWAY ASPHALT TO BE MINIMUM 50mm THICK. GRASSED AREAS TO BE REINSTATED WITH TOPSOIL AND SOD.
6. ALL STREET AND TRAFFIC SIGNAGE DISTURBED DURING CONSTRUCTION SHALL BE RESTORED AS SOON AS POSSIBLE AT THE SAME CHAINAGE LOCATION. APPROPRIATE TEMPORARY STREET AND TRAFFIC SIGNAGE SHALL BE MAINTAINED AT ALL LOCATIONS UNTIL SUCH TIME AS THE PERMANENT SIGNAGE IS RESTORED.
7. ANY INFRASTRUCTURE UNCOVERED DURING THE COURSE OF CONSTRUCTION SHALL BE SURVEYED AND INCLUDED IN THE RECORD/AS-BUILT INFORMATION AS PER SPECIFICATIONS.
8. ALL WORK SHALL BE CONSTRUCTED IN ACCORDANCE WITH THE NSDPW STANDARD SPECIFICATION, HIGHWAY CONSTRUCTION AND MAINTENANCE (LATEST EDITION).

2	PROFILE - EXISTING GRADE OVER NEW SANITARY	JULY 2023
1	ISSUED FOR TENDER	MAY 2023
No.	Revision/Issue	Date

MUNICIPALITY OF THE
COUNTY OF COLCHESTER

1 CHURCH STREET, PO BOX 697 TRURO NS B2N 5E7


AS-BUILTS

Project:
DEBERT SEWER - TRACKER & SPS
(PROJECT NO. 2309-1480)

Drawing Title:
TRACKER ROAD
PLAN & PROFILE
STA. 0+600 TO STA. 0+725


Stamp:	Stamp:

Date:	FEB 2025	Dwg. No.:
Drawn/Checked:	TB / CM	C-05
Scale:	AS NOTED	

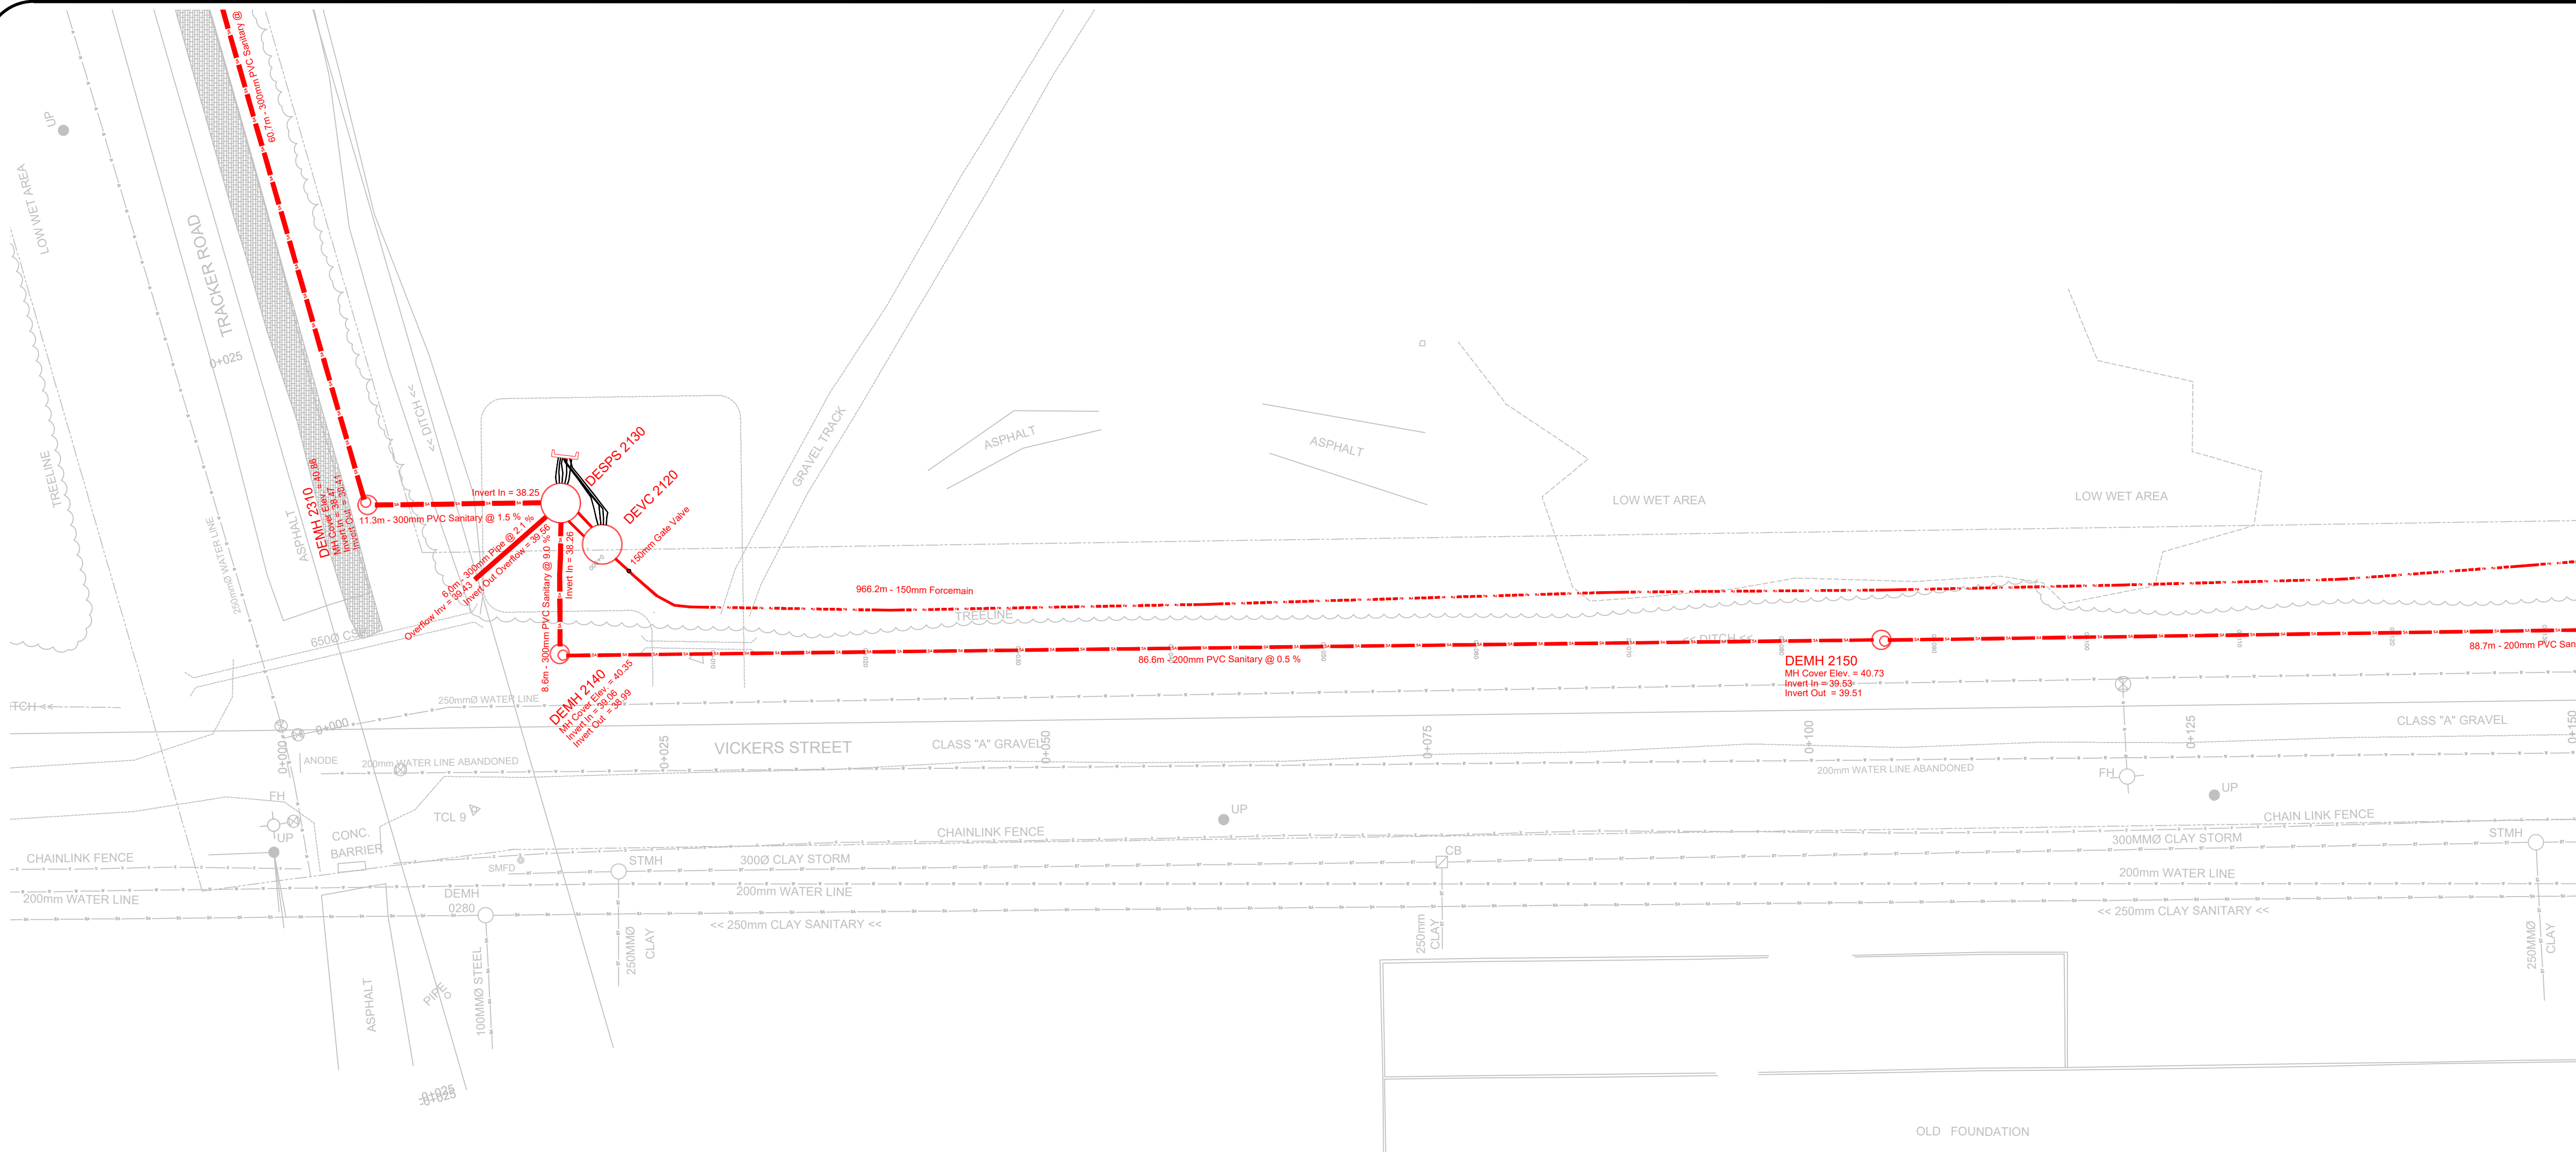


VICKERS STREET PLAN - STA. 0+000 TO STA. 0+150

H = 1 : 250

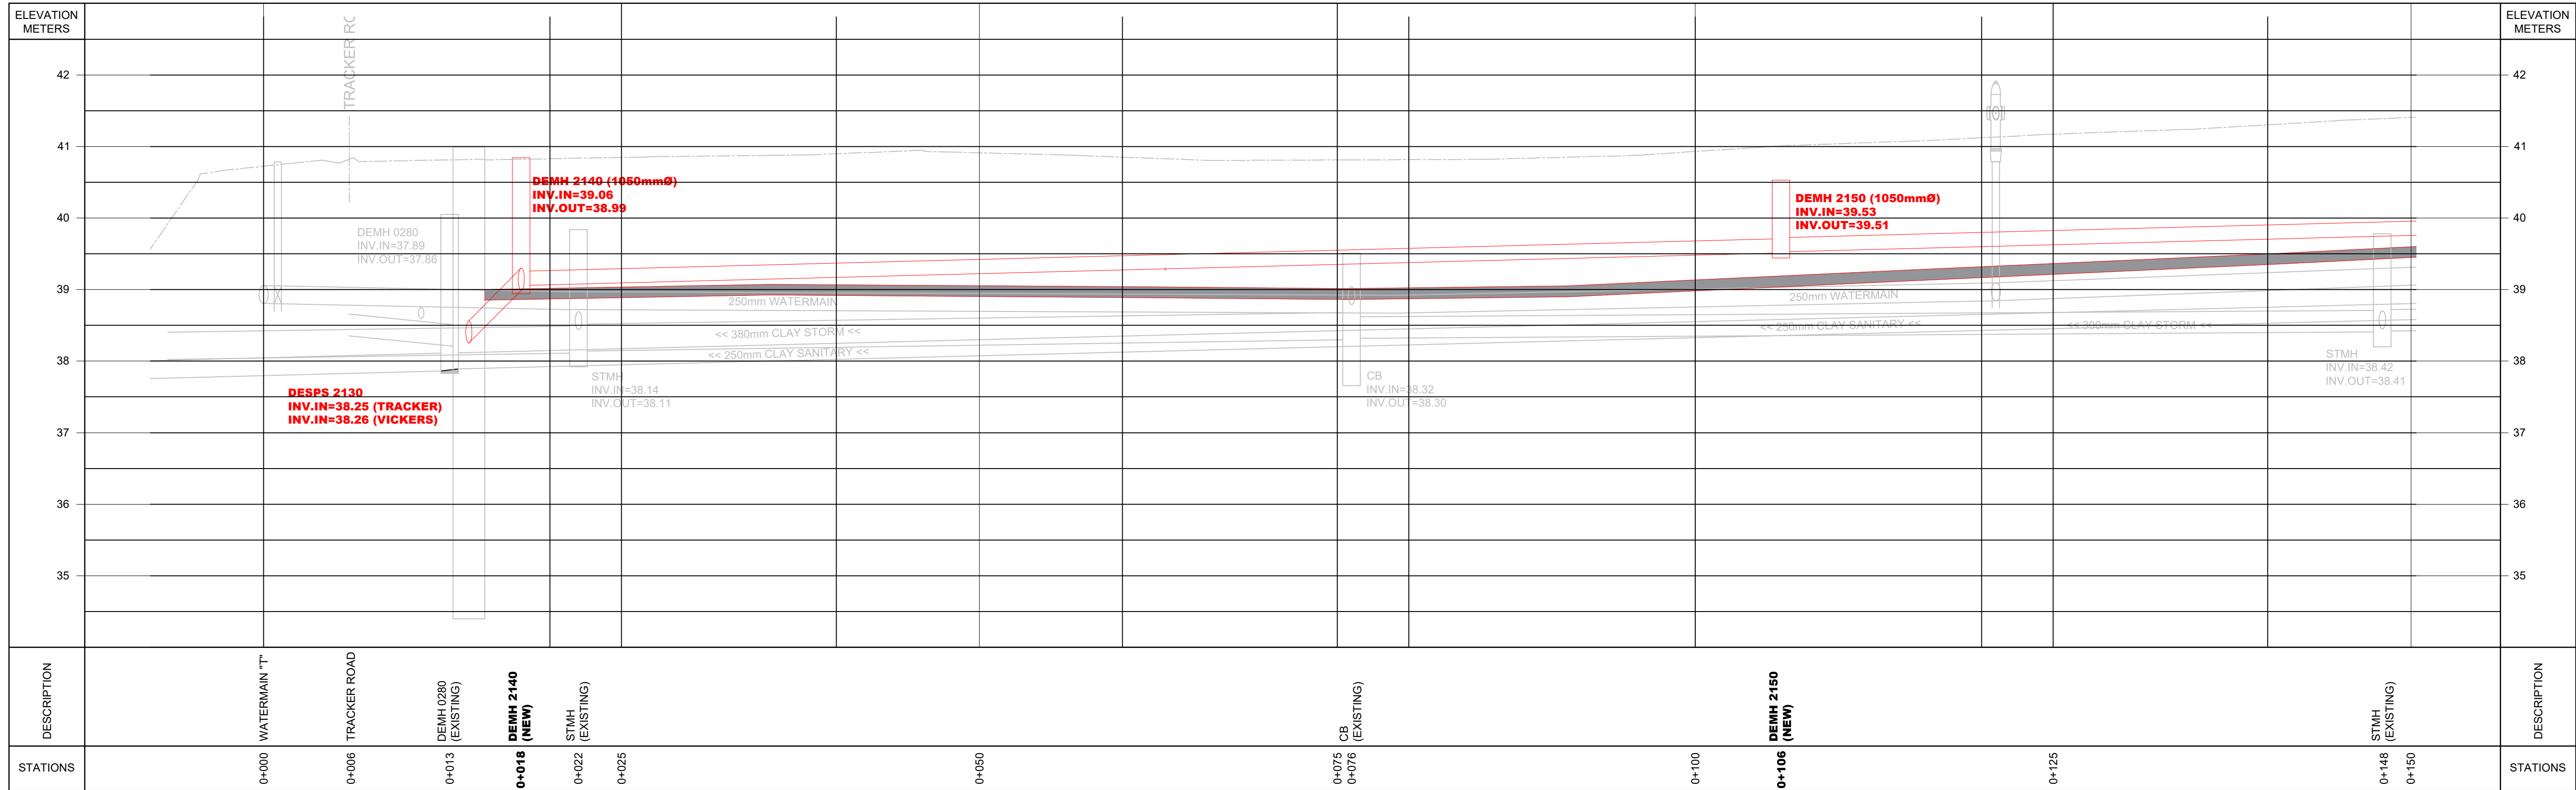

VICKERS STREET PROFILE - STA. 0+000 TO STA. 0+150

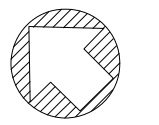

General Notes

1. SURVEY PLAN PROVIDED BY THOMPSON CONN LIMITED.
— SURVEY CARRIED OUT DECEMBER 6 TO DECEMBER 22, 2021.
2. ALL REFERENCE POINTS ARE REFERRED TO NOVA SCOTIA COORDINATE MONUMENT #209547 ELEV. = 57.223. MAP PROJECTION: NOVA SCOTIA 3° MODIFIED MERCATOR PROJECTION, ZONE 5 (CENTRAL MERIDIAN 64°30'W) DATUM: ATS77. BENCHMARKS HAVE BEEN SET WHERE INDICATED.
3. EXISTING BURIED UTILITIES ARE SHOWN AS APPROXIMATE ONLY. LOCATIONS TO BE FIELD VERIFIED AS NECESSARY BY THE CONTRACTOR.
4. CONTRACTOR SHALL COORDINATE WITH N.S.P. FOR RELOCATION OF UTILITY POLES OR GUYS AS REQUIRED.
5. ALL DISTURBED AREAS MUST BE REINSTATED TO ORIGINAL CONDITION OR BETTER. ROAD ASPHALT TO BE MINIMUM 100mm THICK. PARKING LOT AND DRIVEWAY ASPHALT TO BE MINIMUM 50mm THICK. GRASSED AREAS TO BE REINSTATED WITH TOPSOIL AND SOD.
6. ALL STREET AND TRAFFIC SIGNAGE DISTURBED DURING CONSTRUCTION SHALL BE RESTORED AS SOON AS POSSIBLE AT THE SAME CHAINAGE LOCATION. APPROPRIATE TEMPORARY STREET AND TRAFFIC SIGNAGE SHALL BE MAINTAINED AT ALL LOCATIONS UNTIL SUCH TIME AS THE PERMANENT SIGNAGE IS RESTORED.
7. ANY INFRASTRUCTURE UNCOVERED DURING THE COURSE OF CONSTRUCTION SHALL BE SURVEYED AND INCLUDED IN THE RECORD/AS-BUILT INFORMATION AS PER SPECIFICATIONS.
8. ALL WORK SHALL BE CONSTRUCTED IN ACCORDANCE WITH THE NSDPW STANDARD SPECIFICATION, HIGHWAY CONSTRUCTION AND MAINTENANCE (LATEST EDITION).

No.	Revision/Issue	Date
2	PROFILE - EXISTING GRADE OVER NEW SANITARY	JULY 2023
1	ISSUED FOR TENDER	MAY 2023

MUNICIPALITY OF THE
COUNTY OF COLCHESTER

1 CHURCH STREET, PO BOX 697 TRURO NS B2N 5E7


AS-BUILTS

Project:	DEBERT SEWER - TRACKER & SPS (PROJECT NO. 2309-1480)
Drawing Title:	VICKERS STREET PLAN & PROFILE STA. 0+000 TO STA. 0+150

Stamp:	Stamp:
--------	--------


Date:	FEB 2025	Dwg. No.: C-06
Drawn/Chkd.:	TB / CM	
Scale:	AS NOTED	

H = 1 : 250
V = 1 : 50

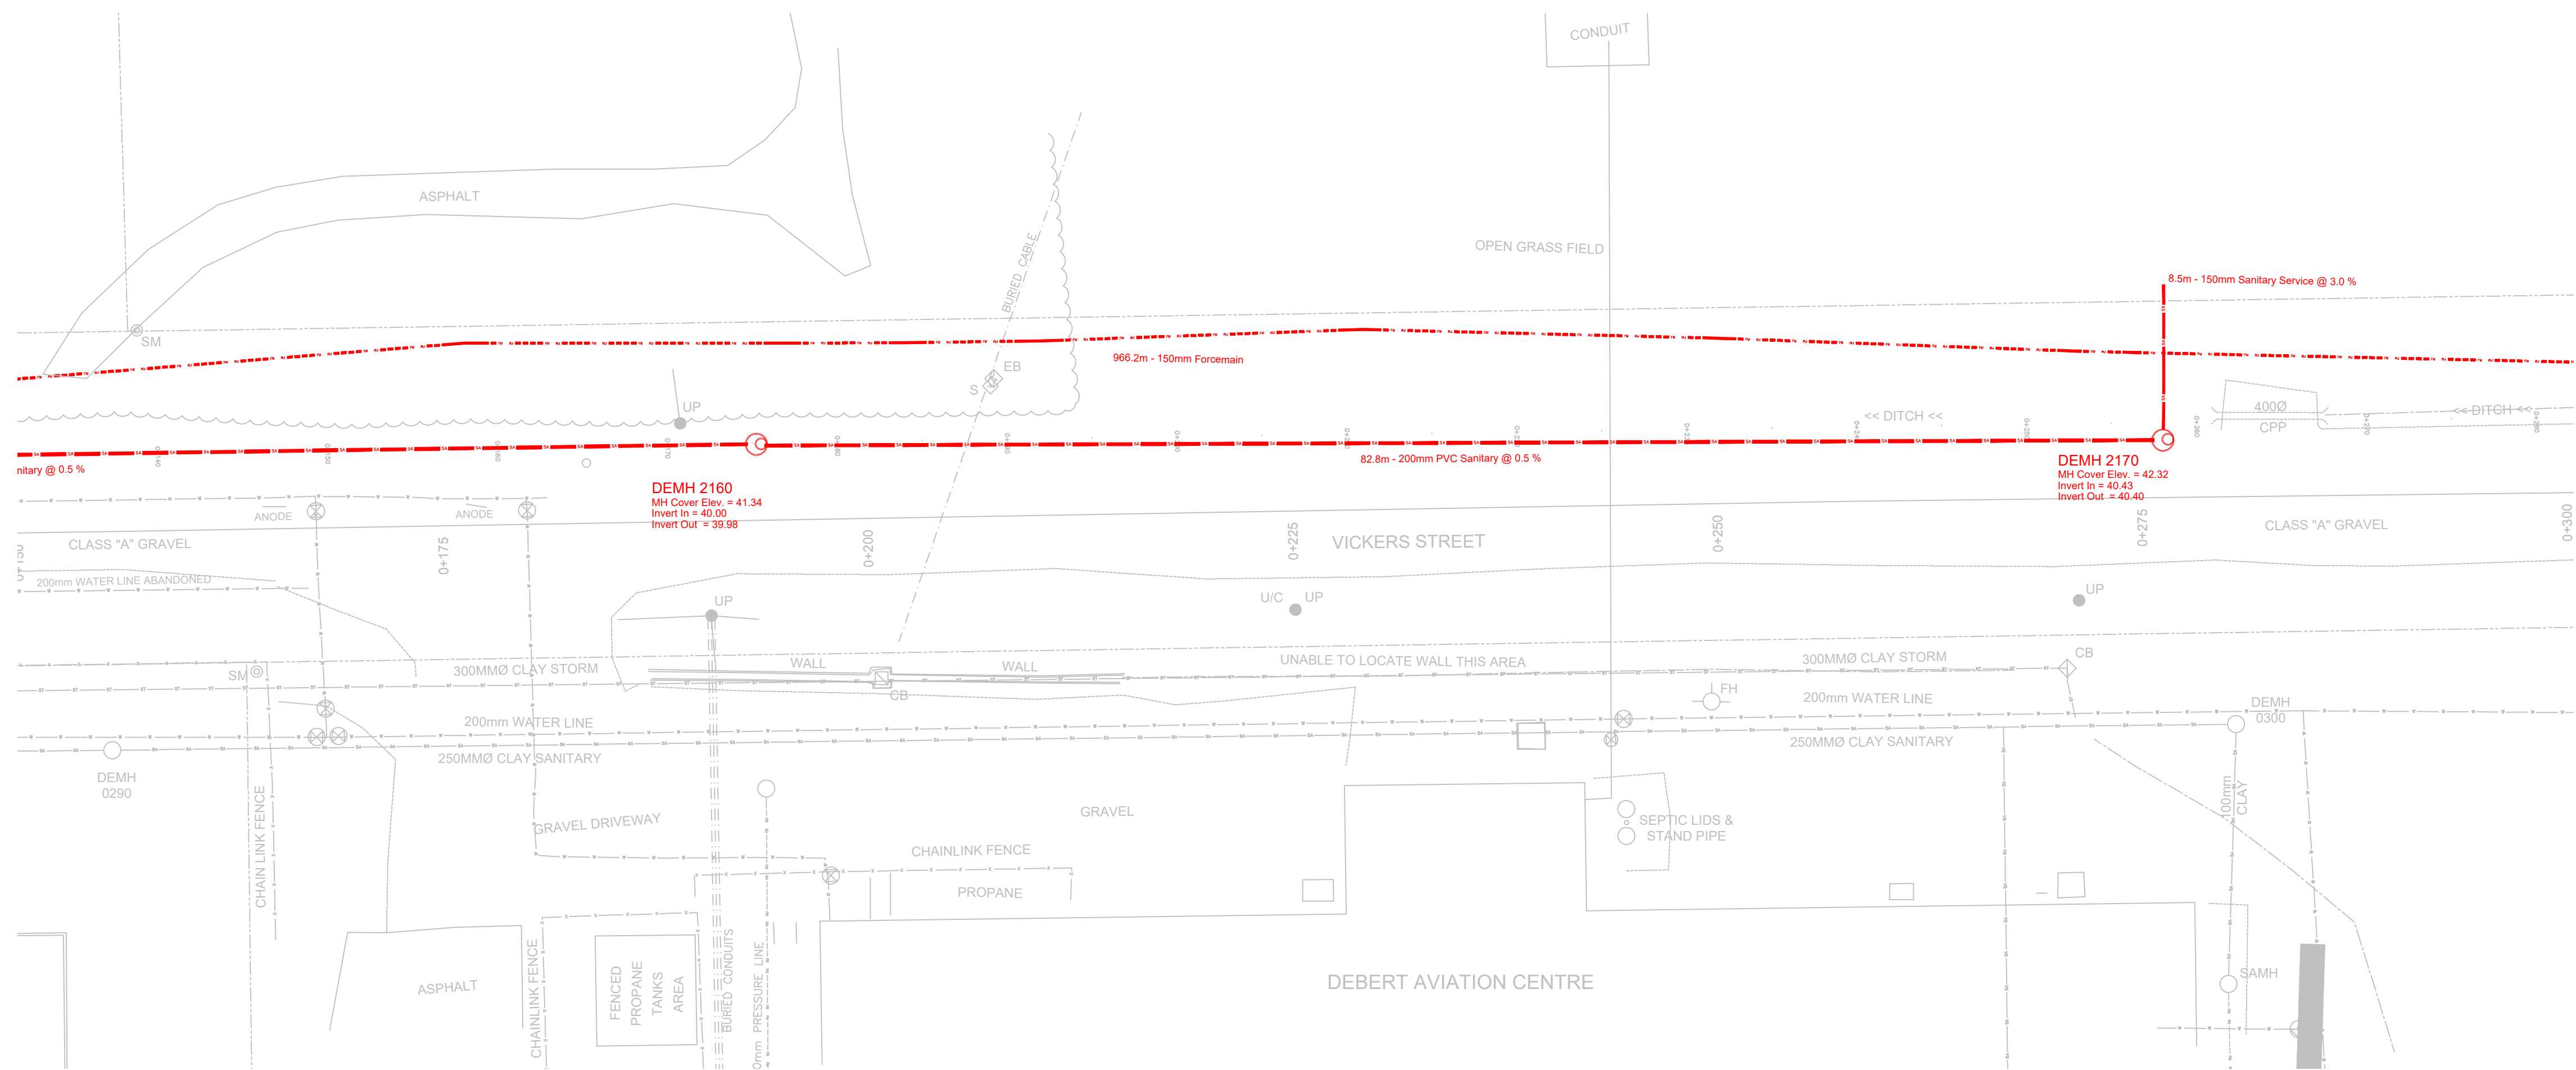

VICKERS STREET PLAN - STA. 0+150 TO STA. 0+300

H = 1 : 250

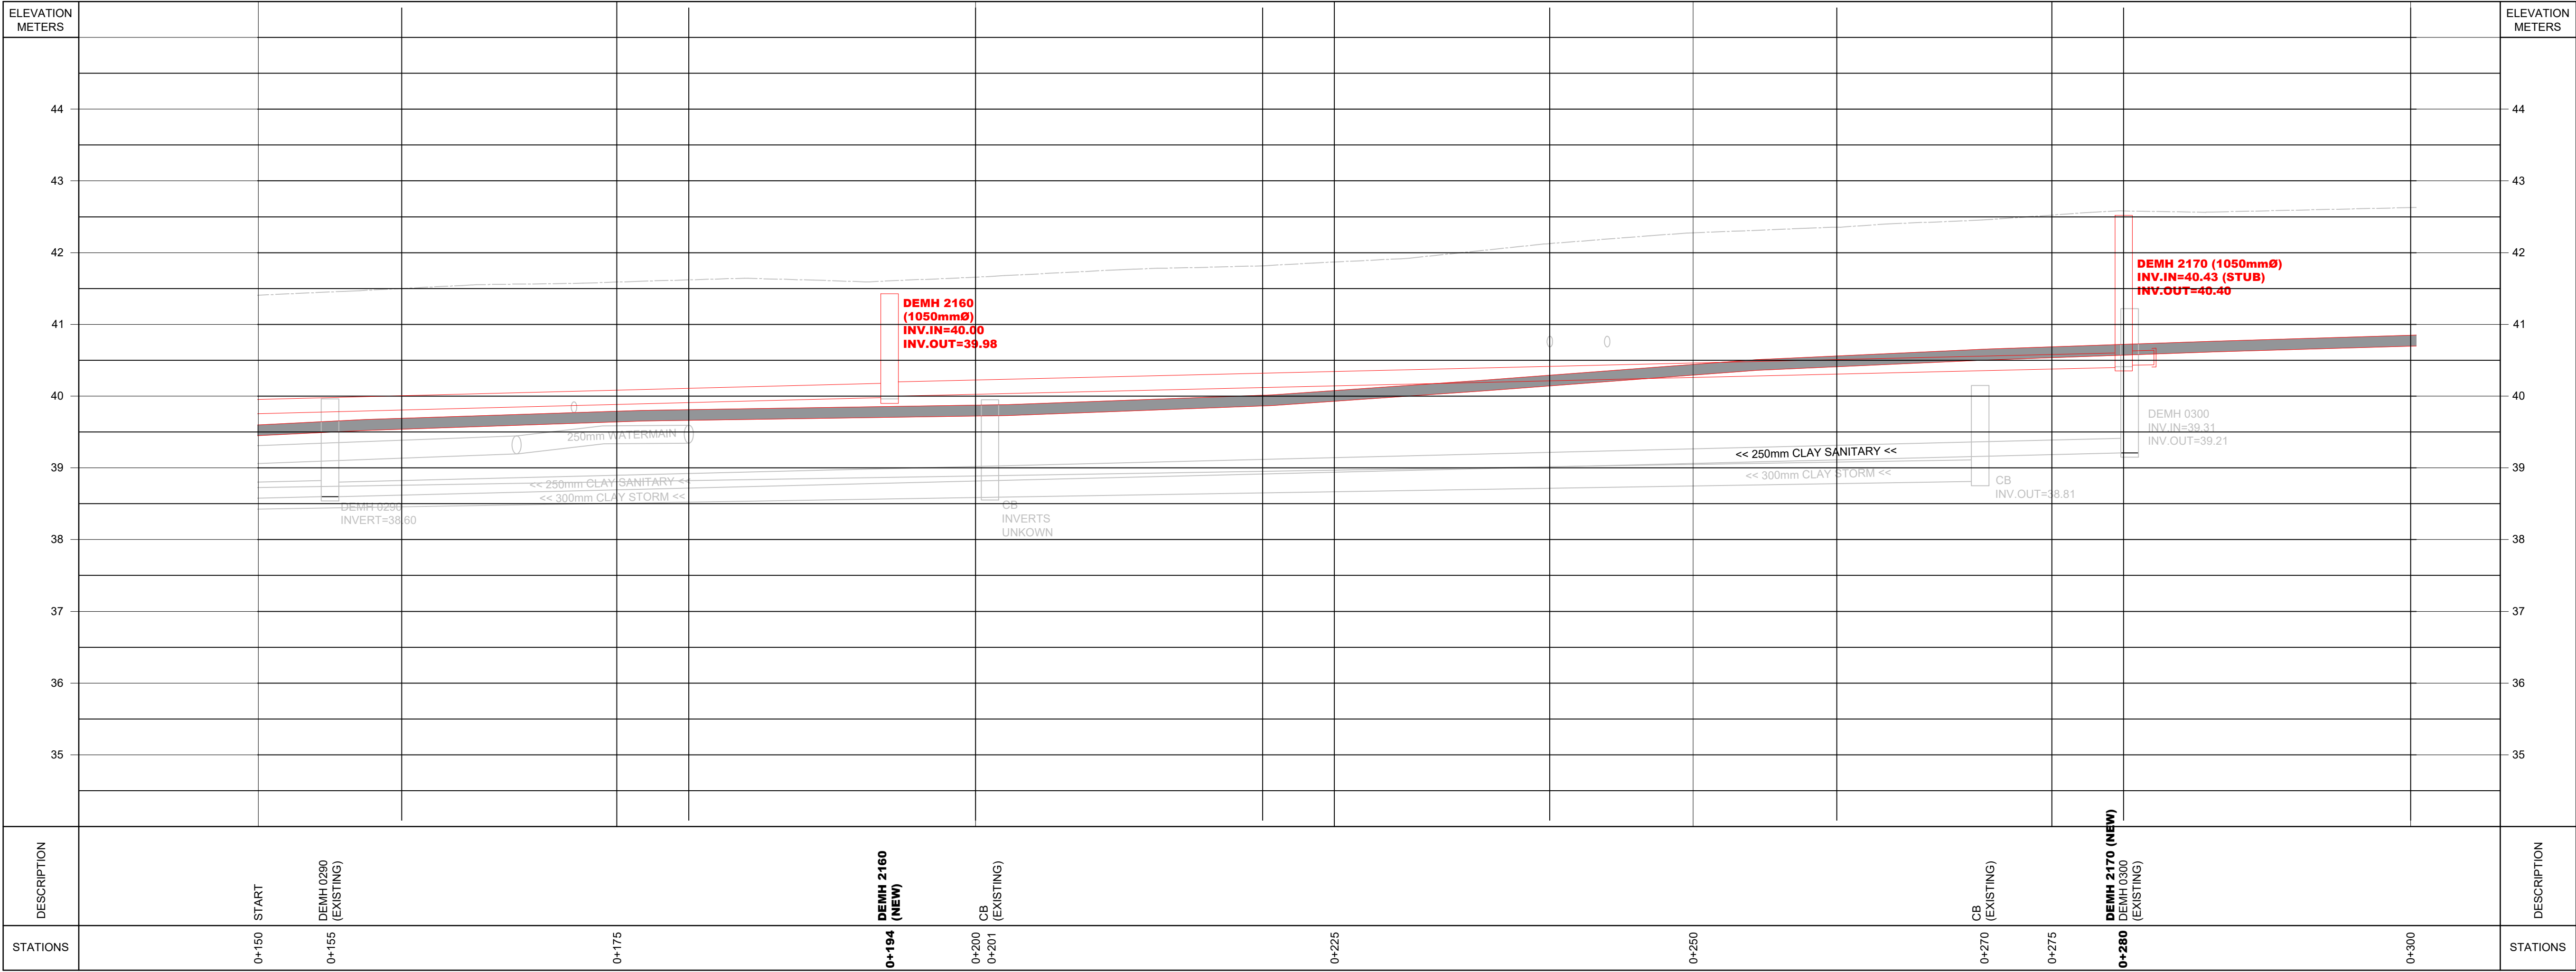

VICKERS STREET PROFILE - STA. 0+150 TO STA. 0+300

H = 1 : 250
V = 1 : 50

General Notes

1. SURVEY PLAN PROVIDED BY THOMPSON CONN LIMITED.
— SURVEY CARRIED OUT DECEMBER 6 TO DECEMBER 22, 2021.
2. ALL REFERENCE POINTS ARE REFERRED TO NOVA SCOTIA COORDINATE MONUMENT #209547 ELEV. = 57.223. MAP PROJECTION: NOVA SCOTIA 3° MODIFIED MERCATOR PROJECTION, ZONE 5 (CENTRAL MERIDIAN 64°30'W) DATUM: AT377. BENCHMARKS HAVE BEEN SET WHERE INDICATED.
3. EXISTING BURIED UTILITIES ARE SHOWN AS APPROXIMATE ONLY. LOCATIONS TO BE FIELD VERIFIED AS NECESSARY BY THE CONTRACTOR.
4. CONTRACTOR SHALL COORDINATE WITH N.S.P. FOR RELOCATION OF UTILITY POLES OR GUYS AS REQUIRED.
5. ALL DISTURBED AREAS MUST BE REINSTATED TO ORIGINAL CONDITION OR BETTER. ROAD ASPHALT TO BE MINIMUM 100mm THICK. PARKING LOT AND DRIVEWAY ASPHALT TO BE MINIMUM 50mm THICK. GRASSED AREAS TO BE REINSTATED WITH TOPSOIL AND SOD.
6. ALL STREET AND TRAFFIC SIGNAGE DISTURBED DURING CONSTRUCTION SHALL BE RESTORED AS SOON AS POSSIBLE AT THE SAME CHAINAGE LOCATION. APPROPRIATE TEMPORARY STREET AND TRAFFIC SIGNAGE SHALL BE MAINTAINED AT ALL LOCATIONS UNTIL SUCH TIME AS THE PERMANENT SIGNAGE IS RESTORED.
7. ANY INFRASTRUCTURE UNCOVERED DURING THE COURSE OF CONSTRUCTION SHALL BE SURVEYED AND INCLUDED IN THE RECORD/AS-BUILT INFORMATION AS PER SPECIFICATIONS.
8. ALL WORK SHALL BE CONSTRUCTED IN ACCORDANCE WITH THE NSDPW STANDARD SPECIFICATION, HIGHWAY CONSTRUCTION AND MAINTENANCE (LATEST EDITION).

2	PROFILE - EXISTING GRADE OVER NEW SANITARY	JULY 2023
1	ISSUED FOR TENDER	MAY 2023
No.	Revision/Issue	Date

MUNICIPALITY OF THE
COUNTY OF COLCHESTER

1 CHURCH STREET, PO BOX 697 TRURO NS B2N 5E7



AS-BUILTS

Project:
DEBERT SEWER - TRACKER & SPS
(PROJECT NO. 2309-1480)

Drawing Title:
VICKERS STREET
PLAN & PROFILE
STA. 0+150 TO STA. 0+300


Stamp:	Stamp:

Date:	FEB 2025	Dwg. No.:	C-07
Drawn/Checked:	TB / CM		
Scale:	AS NOTED		

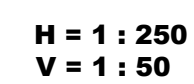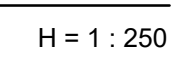


- | | | |
|--------------|----------|------------------------------|
| Date: | FEB 2025 | Dwg. No.:

C-08 |
| Drawn/Chkd.: | TB / CM | |
| Scale: | AS NOTED | |

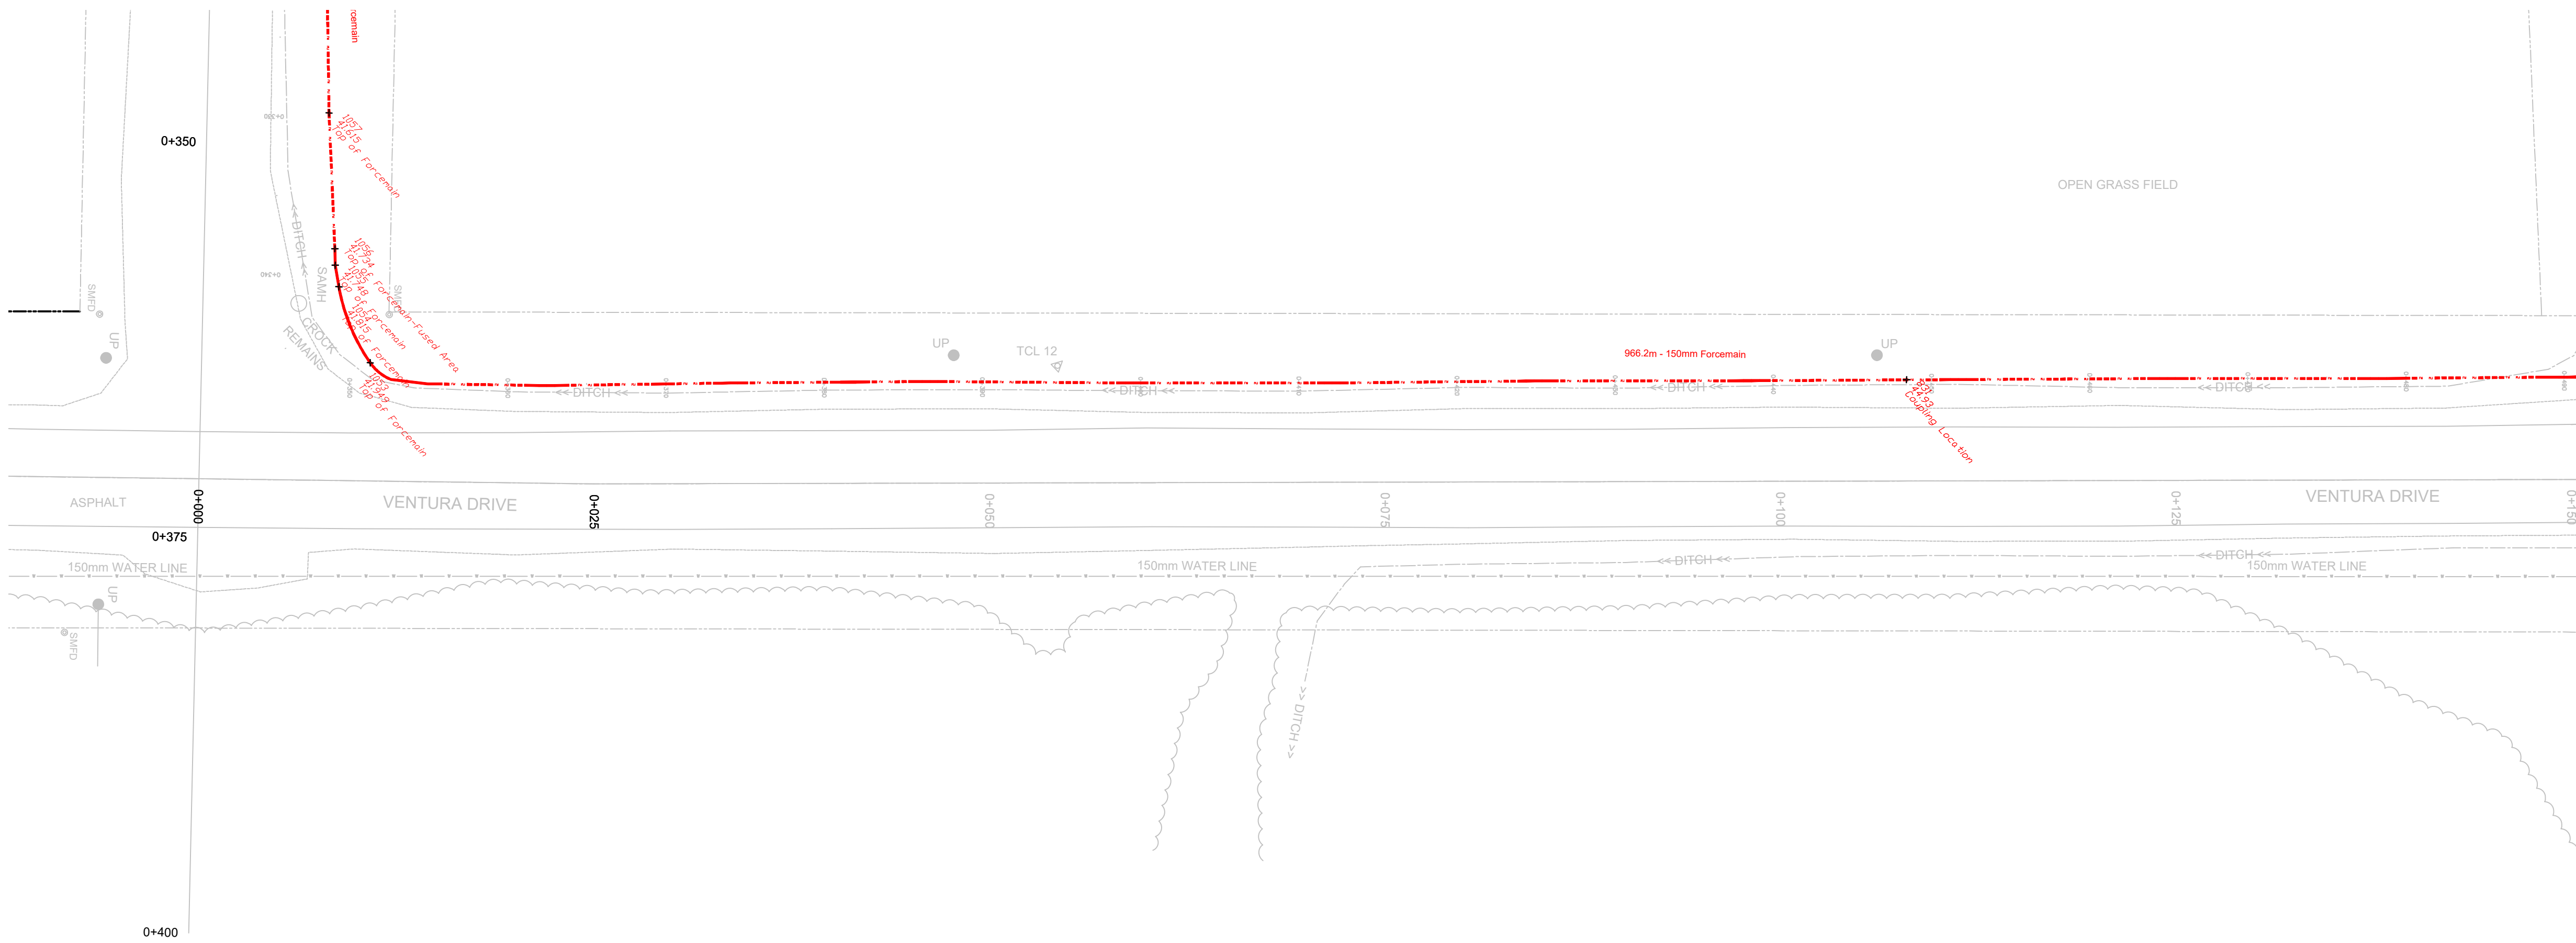


VENTURA DRIVE PLAN - STA. 0+000 TO STA. 0+150

H = 1 : 250

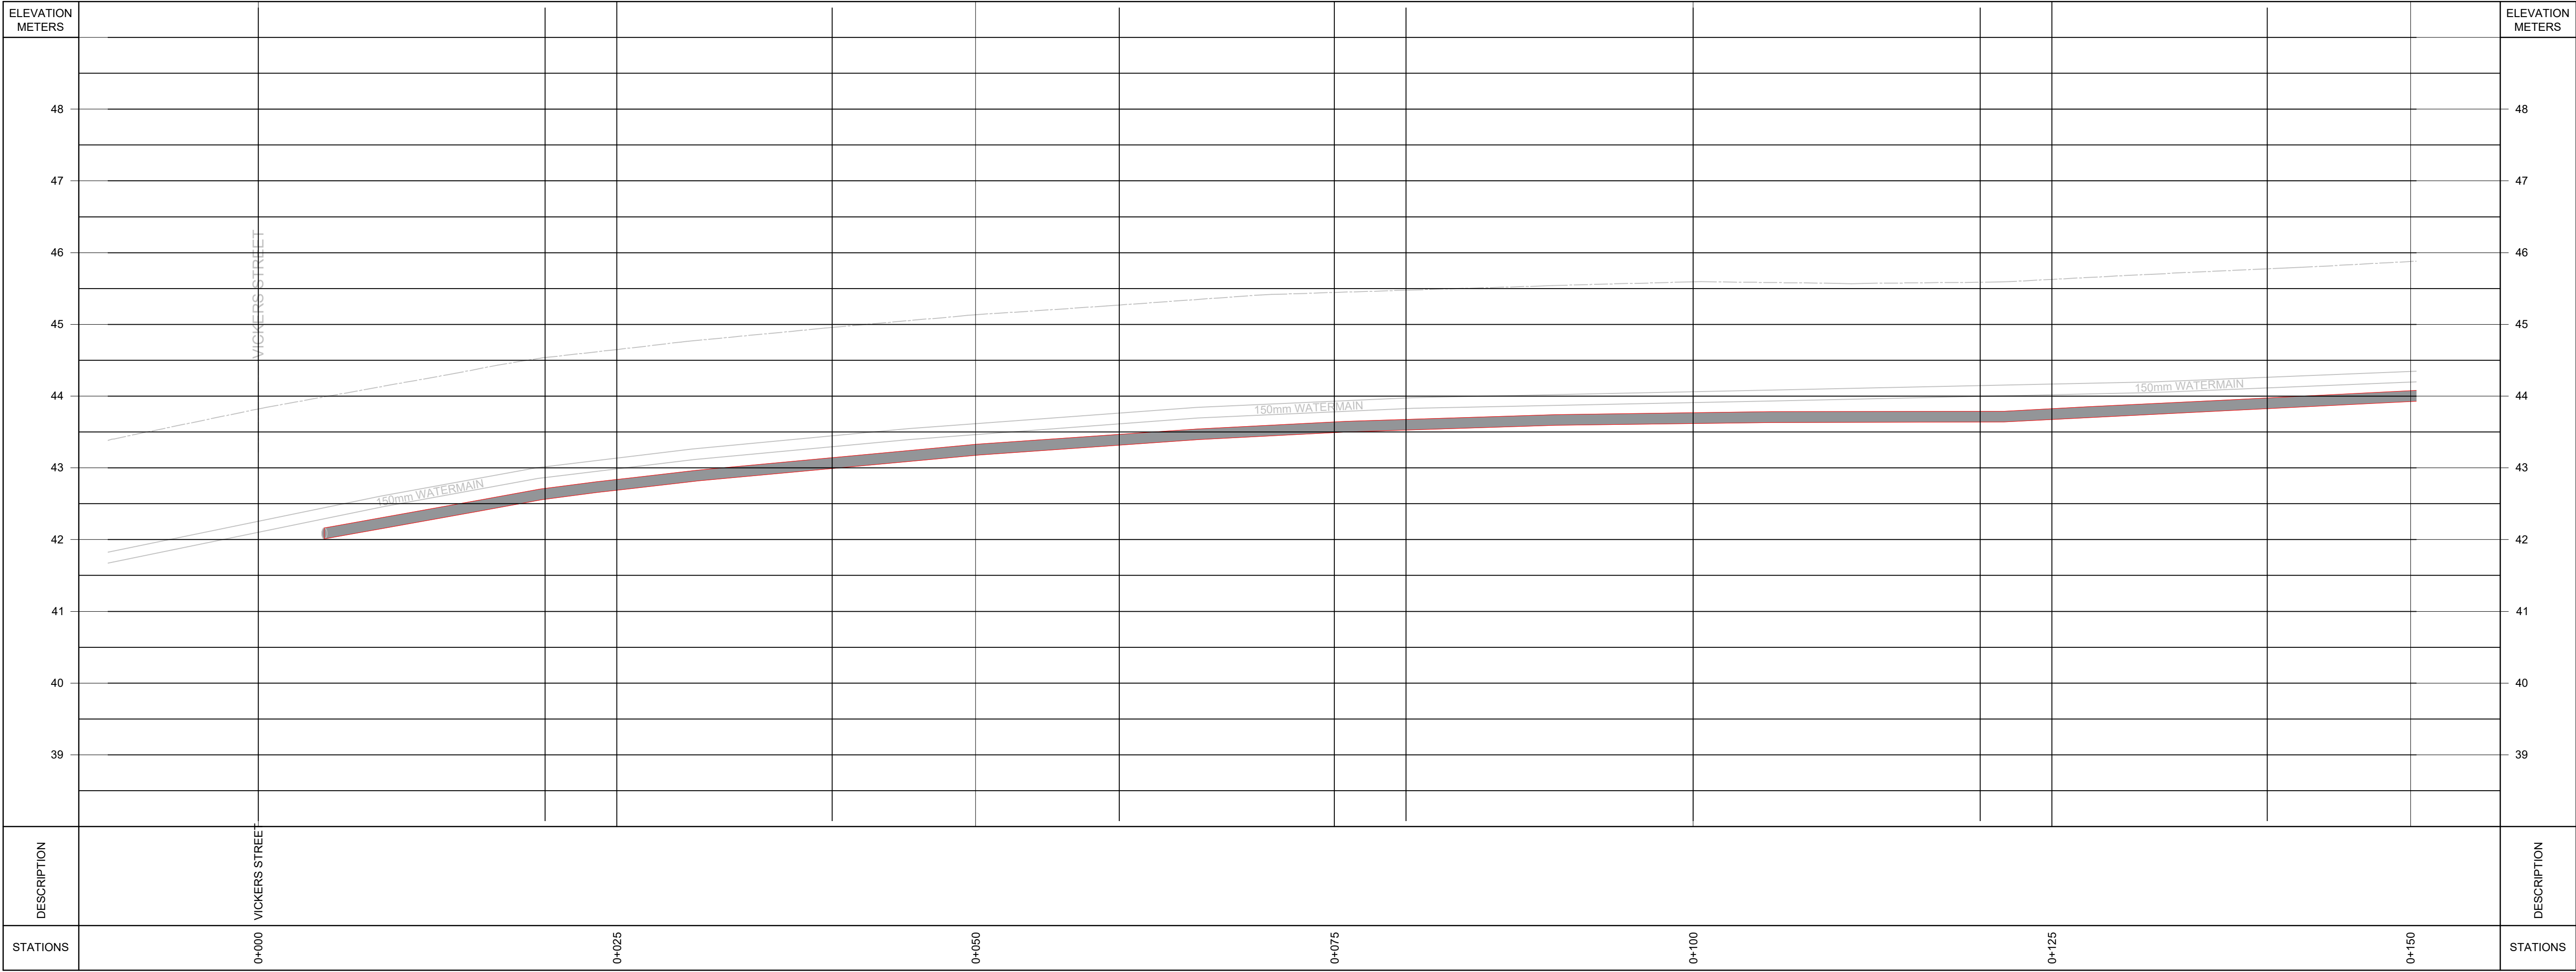

VENTURA DRIVE PROFILE - STA. 0+000 TO STA. 0+150

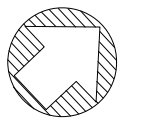

General Notes

1. SURVEY PLAN PROVIDED BY THOMPSON CONN LIMITED.
— SURVEY CARRIED OUT DECEMBER 6 TO DECEMBER 22, 2021.
2. ALL REFERENCE POINTS ARE REFERRED TO NOVA SCOTIA COORDINATE MONUMENT #209547 ELEV. = 57.223. MAP PROJECTION: NOVA SCOTIA 3" MODIFIED MERCATOR PROJECTION, ZONE 5 (CENTRAL MERIDIAN 64°30'W) DATUM: AT377. BENCHMARKS HAVE BEEN SET WHERE INDICATED.
3. EXISTING BURIED UTILITIES ARE SHOWN AS APPROXIMATE ONLY. LOCATIONS TO BE FIELD VERIFIED AS NECESSARY BY THE CONTRACTOR.
4. CONTRACTOR SHALL COORDINATE WITH N.S.P. FOR RELOCATION OF UTILITY POLES OR GUYS AS REQUIRED.
5. ALL DISTURBED AREAS MUST BE REINSTATED TO ORIGINAL CONDITION OR BETTER. ROAD ASPHALT TO BE MINIMUM 100mm THICK. PARKING LOT AND DRIVEWAY ASPHALT TO BE MINIMUM 50mm THICK. GRASSED AREAS TO BE REINSTATED WITH TOPSOIL AND SOD.
6. ALL STREET AND TRAFFIC SIGNAGE DISTURBED DURING CONSTRUCTION SHALL BE RESTORED AS SOON AS POSSIBLE AT THE SAME CHAINAGE LOCATION. APPROPRIATE TEMPORARY STREET AND TRAFFIC SIGNAGE SHALL BE MAINTAINED AT ALL LOCATIONS UNTIL SUCH TIME AS THE PERMANENT SIGNAGE IS RESTORED.
7. ANY INFRASTRUCTURE UNCOVERED DURING THE COURSE OF CONSTRUCTION SHALL BE SURVEYED AND INCLUDED IN THE RECORD/AS-BUILT INFORMATION AS PER SPECIFICATIONS.
8. ALL WORK SHALL BE CONSTRUCTED IN ACCORDANCE WITH THE NSDPW STANDARD SPECIFICATION, HIGHWAY CONSTRUCTION AND MAINTENANCE (LATEST EDITION).

1	ISSUED FOR TENDER	MAY 2023
No.	Revision/Issue	Date

MUNICIPALITY OF THE
COUNTY OF COLCHESTER

1 CHURCH STREET, PO BOX 697 TRURO NS B2N 5E7

AS-BUILTS


Project:
DEBERT SEWER - TRACKER & SPS
(PROJECT NO. 2309-1480)

Drawing Title:
VENTURA DRIVE
PLAN & PROFILE
STA. 0+000 TO STA. 0+150

Stamp:	Stamp:


Date:	FEB 2025	Dwg. No.:
Drawn/Checked:	TB / CM	C-09
Scale:	AS NOTED	

H = 1 : 250
V = 1 : 50

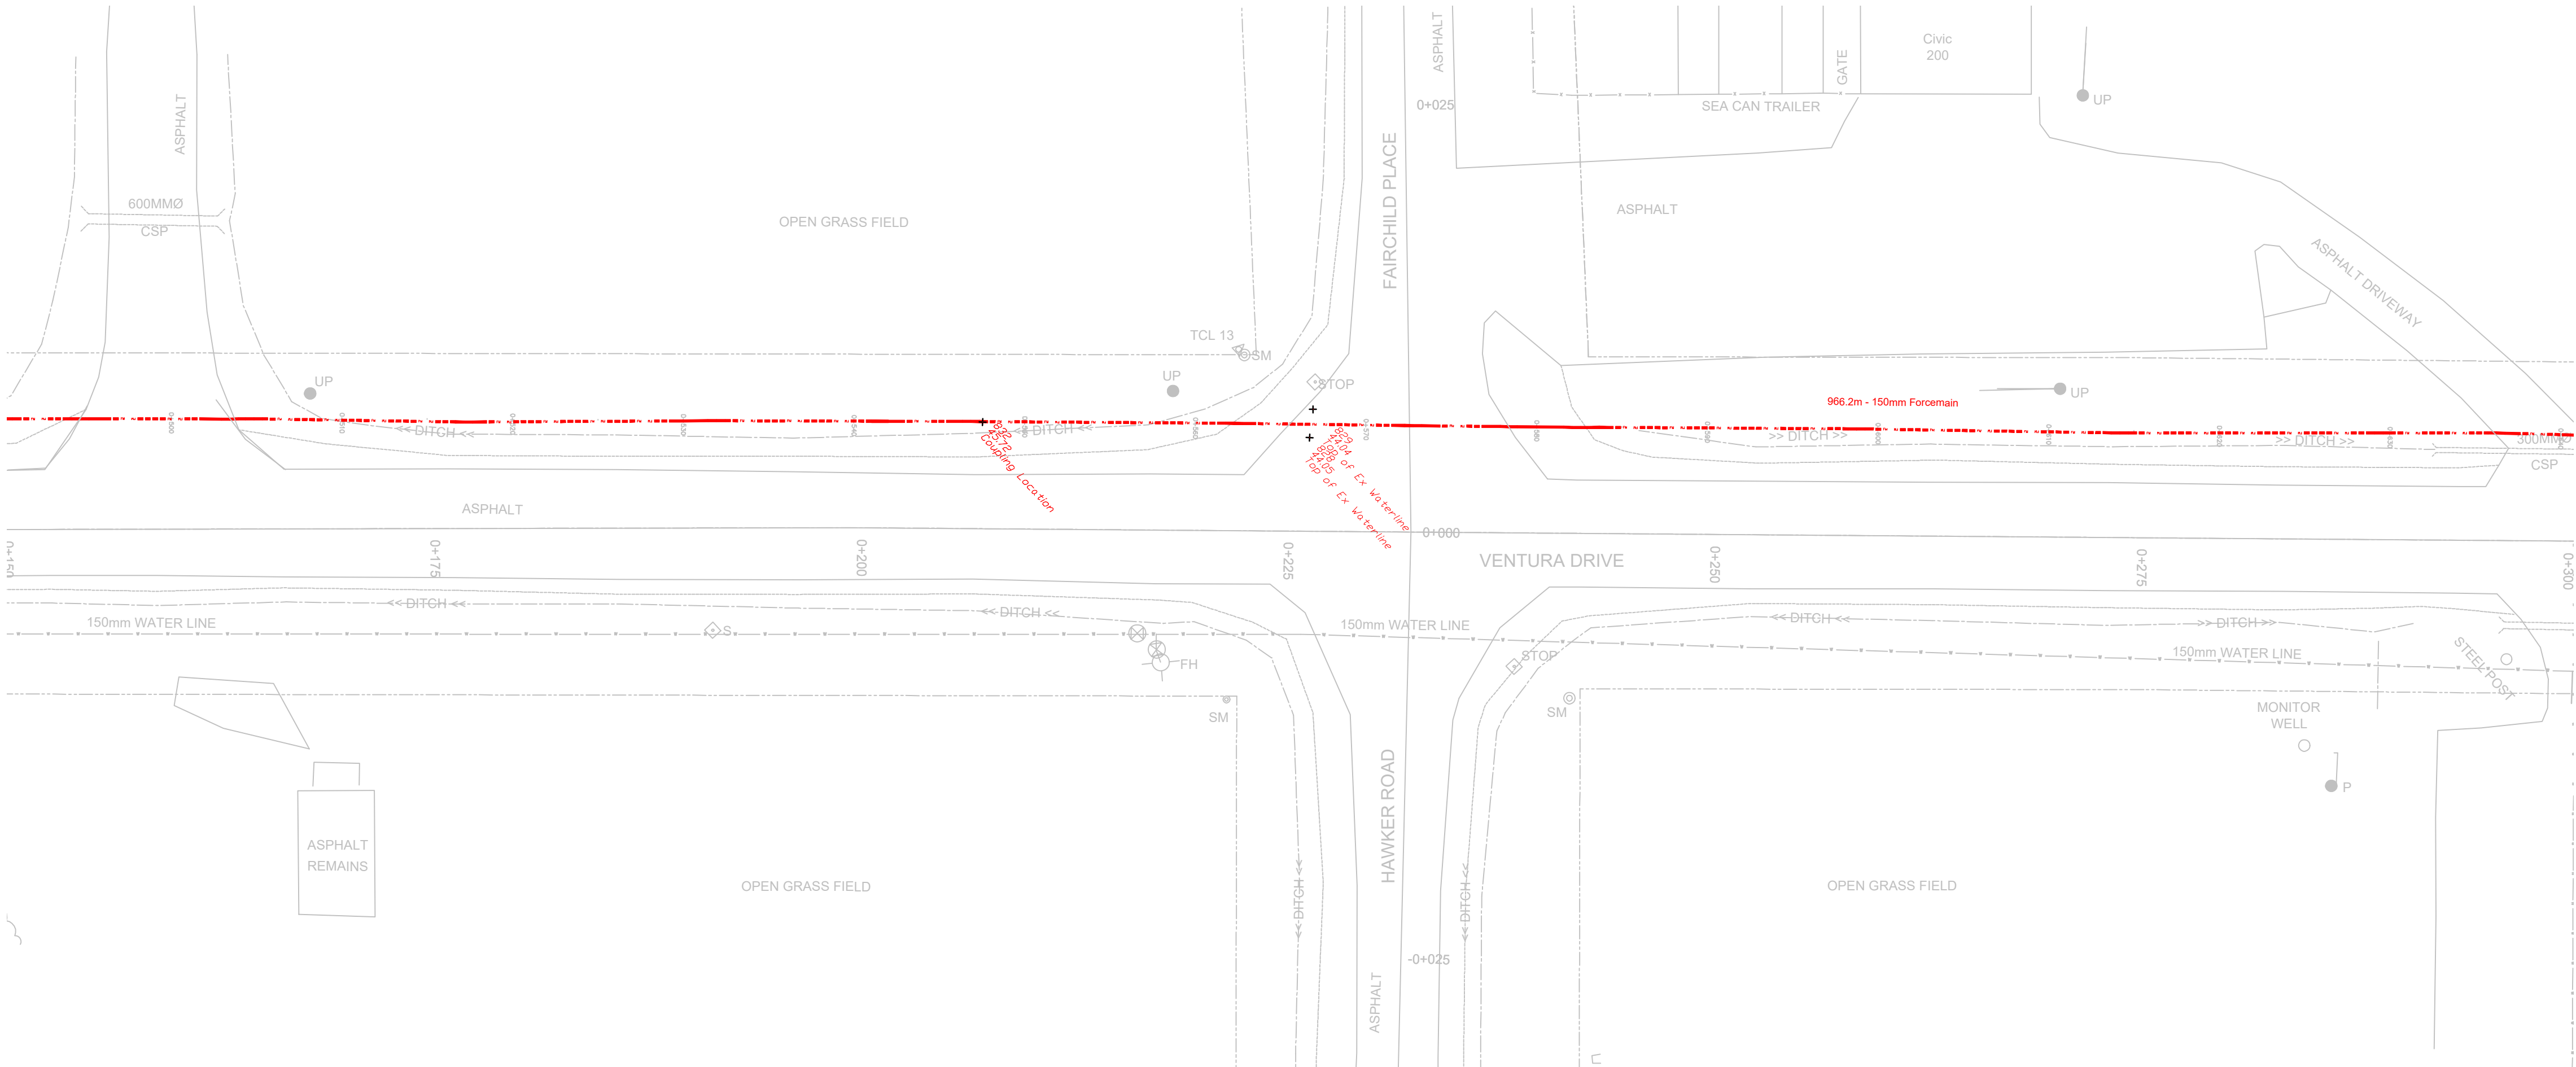

VENTURA DRIVE PLAN - STA. 0+150 TO STA. 0+300

H = 1 : 250

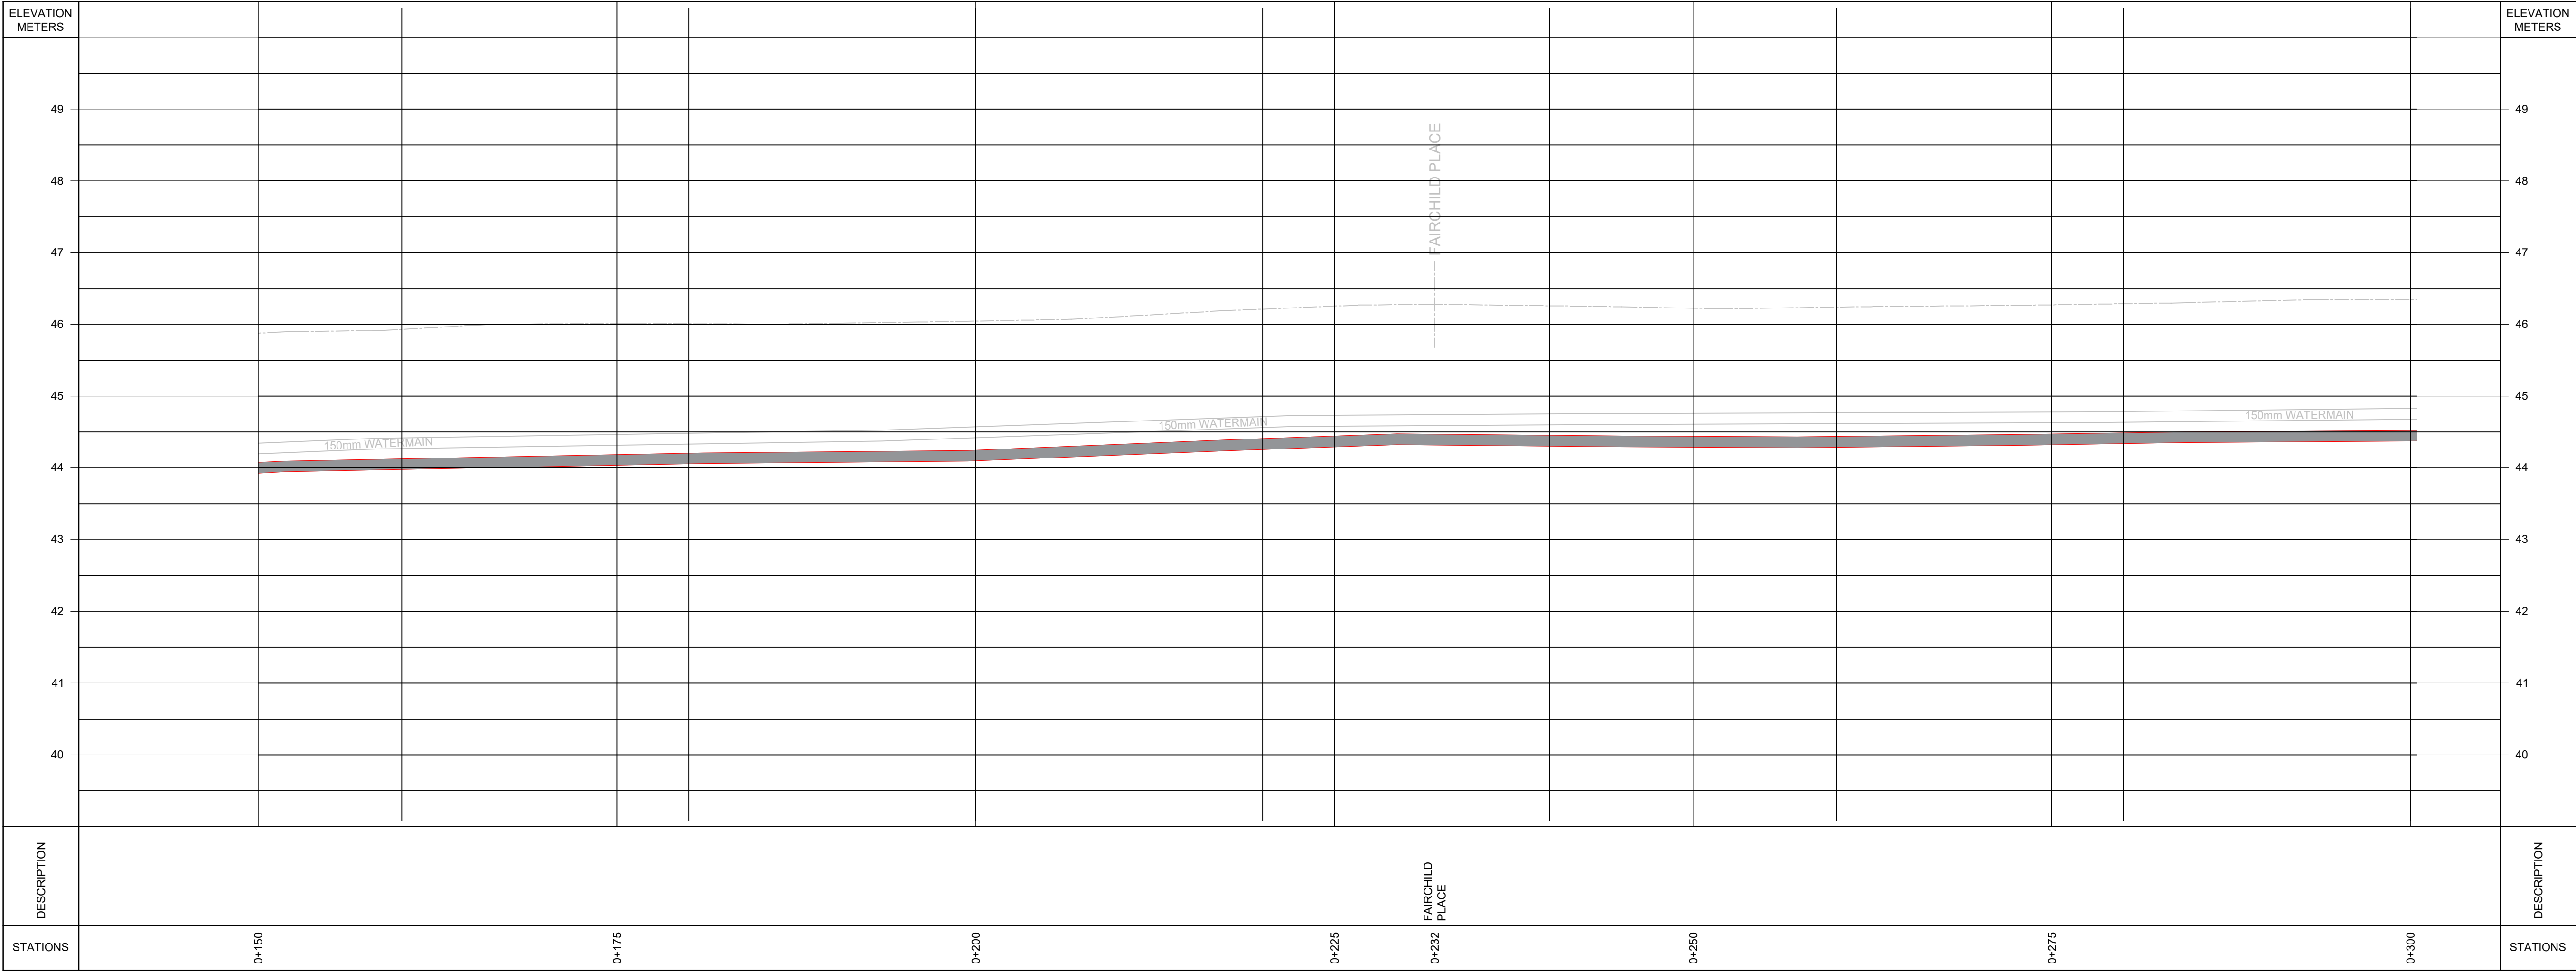

VENTURA DRIVE PROFILE - STA. 0+150 TO STA. 0+300

H = 1 : 250
V = 1 : 50

General Notes

1. SURVEY PLAN PROVIDED BY THOMPSON CONN LIMITED.
— SURVEY CARRIED OUT DECEMBER 6 TO DECEMBER 22, 2021.
2. ALL REFERENCE POINTS ARE REFERRED TO NOVA SCOTIA COORDINATE MONUMENT #209547 ELEV. = 57.223. MAP PROJECTION: NOVA SCOTIA 3° MODIFIED MERCATOR PROJECTION, ZONE 5 (CENTRAL MERIDIAN 64°30'W) DATUM: ATS77. BENCHMARKS HAVE BEEN SET WHERE INDICATED.
3. EXISTING BURIED UTILITIES ARE SHOWN AS APPROXIMATE ONLY. LOCATIONS TO BE FIELD VERIFIED AS NECESSARY BY THE CONTRACTOR.
4. CONTRACTOR SHALL COORDINATE WITH N.S.P. FOR RELOCATION OF UTILITY POLES OR GUYS AS REQUIRED.
5. ALL DISTURBED AREAS MUST BE REINSTATED TO ORIGINAL CONDITION OR BETTER. ROAD ASPHALT TO BE MINIMUM 100mm THICK. PARKING LOT AND DRIVEWAY ASPHALT TO BE MINIMUM 50mm THICK. GRASSED AREAS TO BE REINSTATED WITH TOPSOIL AND SOD.
6. ALL STREET AND TRAFFIC SIGNAGE DISTURBED DURING CONSTRUCTION SHALL BE RESTORED AS SOON AS POSSIBLE AT THE SAME CHAINAGE LOCATION. APPROPRIATE TEMPORARY STREET AND TRAFFIC SIGNAGE SHALL BE MAINTAINED AT ALL LOCATIONS UNTIL SUCH TIME AS THE PERMANENT SIGNAGE IS RESTORED.
7. ANY INFRASTRUCTURE UNCOVERED DURING THE COURSE OF CONSTRUCTION SHALL BE SURVEYED AND INCLUDED IN THE RECORD/AS-BUILT INFORMATION AS PER SPECIFICATIONS.
8. ALL WORK SHALL BE CONSTRUCTED IN ACCORDANCE WITH THE NSDPW STANDARD SPECIFICATION, HIGHWAY CONSTRUCTION AND MAINTENANCE (LATEST EDITION).

1	ISSUED FOR TENDER	MAY 2023
No.	Revision/Issue	Date

MUNICIPALITY OF THE
COUNTY OF COLCHESTER

1 CHURCH STREET, PO BOX 697 TRURO NS B2N 5E7


AS-BUILTS

Project:
DEBERT SEWER - TRACKER & SPS
(PROJECT NO. 2309-1480)

Drawing Title:
VENTURA DRIVE
PLAN & PROFILE
STA. 0+150 TO STA. 0+300

Stamp:	Stamp:

Date:	FEB 2025	Dwg. No.:
Drawn/Checked:	TB / CM	C-10
Scale:	AS NOTED	

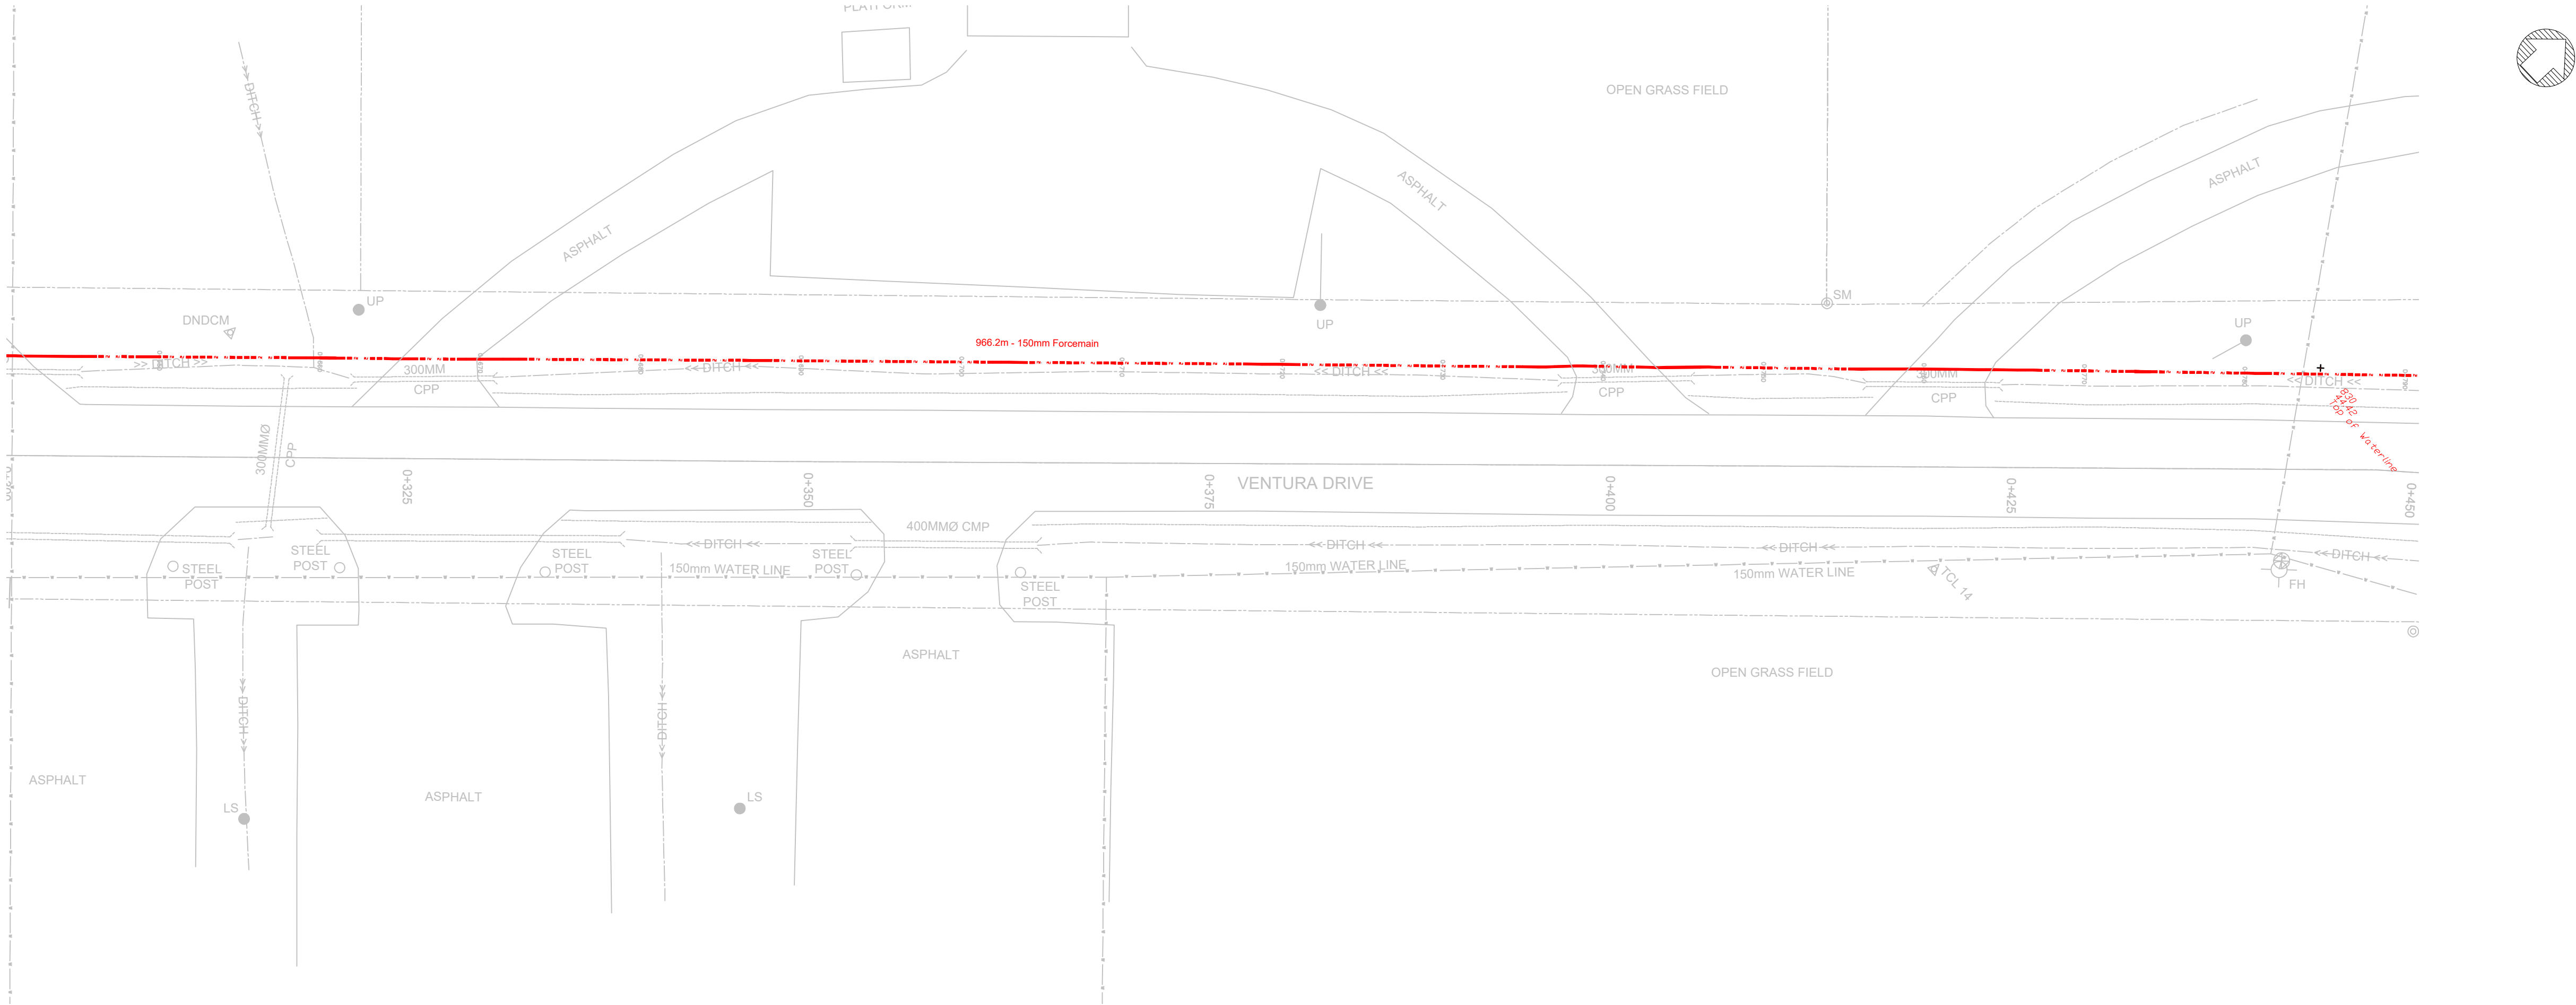

VENTURA DRIVE PLAN - STA. 0+300 TO STA. 0+450

H = 1 : 250



VENTURA DRIVE PROFILE - STA. 0+300 TO STA. 0+450

H = 1 : 250
V = 1 : 50

General Notes

1. SURVEY PLAN PROVIDED BY THOMPSON CONN LIMITED.
— SURVEY CARRIED OUT DECEMBER 6 TO DECEMBER 22, 2021.
2. ALL REFERENCE POINTS ARE REFERRED TO NOVA SCOTIA COORDINATE MONUMENT #209547 ELEV. = 57.223. MAP PROJECTION: NOVA SCOTIA 3° MODIFIED MERCATOR PROJECTION, ZONE 5 (CENTRAL MERIDIAN 64°30'W) DATUM: AT377. BENCHMARKS HAVE BEEN SET WHERE INDICATED.
3. EXISTING BURIED UTILITIES ARE SHOWN AS APPROXIMATE ONLY. LOCATIONS TO BE FIELD VERIFIED AS NECESSARY BY THE CONTRACTOR.
4. CONTRACTOR SHALL COORDINATE WITH N.S.P. FOR RELOCATION OF UTILITY POLES OR GUYS AS REQUIRED.
5. ALL DISTURBED AREAS MUST BE REINSTATED TO ORIGINAL CONDITION OR BETTER. ROAD ASPHALT TO BE MINIMUM 100mm THICK. PARKING LOT AND DRIVEWAY ASPHALT TO BE MINIMUM 50mm THICK. GRASSED AREAS TO BE REINSTATED WITH TOPSOIL AND SOD.
6. ALL STREET AND TRAFFIC SIGNAGE DISTURBED DURING CONSTRUCTION SHALL BE RESTORED AS SOON AS POSSIBLE AT THE SAME CHAINAGE LOCATION. APPROPRIATE TEMPORARY STREET AND TRAFFIC SIGNAGE SHALL BE MAINTAINED AT ALL LOCATIONS UNTIL SUCH TIME AS THE PERMANENT SIGNAGE IS RESTORED.
7. ANY INFRASTRUCTURE UNCOVERED DURING THE COURSE OF CONSTRUCTION SHALL BE SURVEYED AND INCLUDED IN THE RECORD/AS-BUILT INFORMATION AS PER SPECIFICATIONS.
8. ALL WORK SHALL BE CONSTRUCTED IN ACCORDANCE WITH THE NSDPW STANDARD SPECIFICATION, HIGHWAY CONSTRUCTION AND MAINTENANCE (LATEST EDITION).

1	ISSUED FOR TENDER	MAY 2023
No.	Revision/Issue	Date

MUNICIPALITY OF THE
COUNTY OF COLCHESTER

1 CHURCH STREET, PO BOX 697 TRURO NS B2N 5E7


AS-BUILTS

Project:
DEBERT SEWER - TRACKER & SPS
(PROJECT NO. 2309-1480)

Drawing Title:
VENTURA DRIVE
PLAN & PROFILE
STA. 0+300 TO STA. 0+450


Stamp:	Stamp:

Date:	FEB 2025	Dwg. No.:
Drawn/Checked:	TB / CM	C-11
Scale:	AS NOTED	

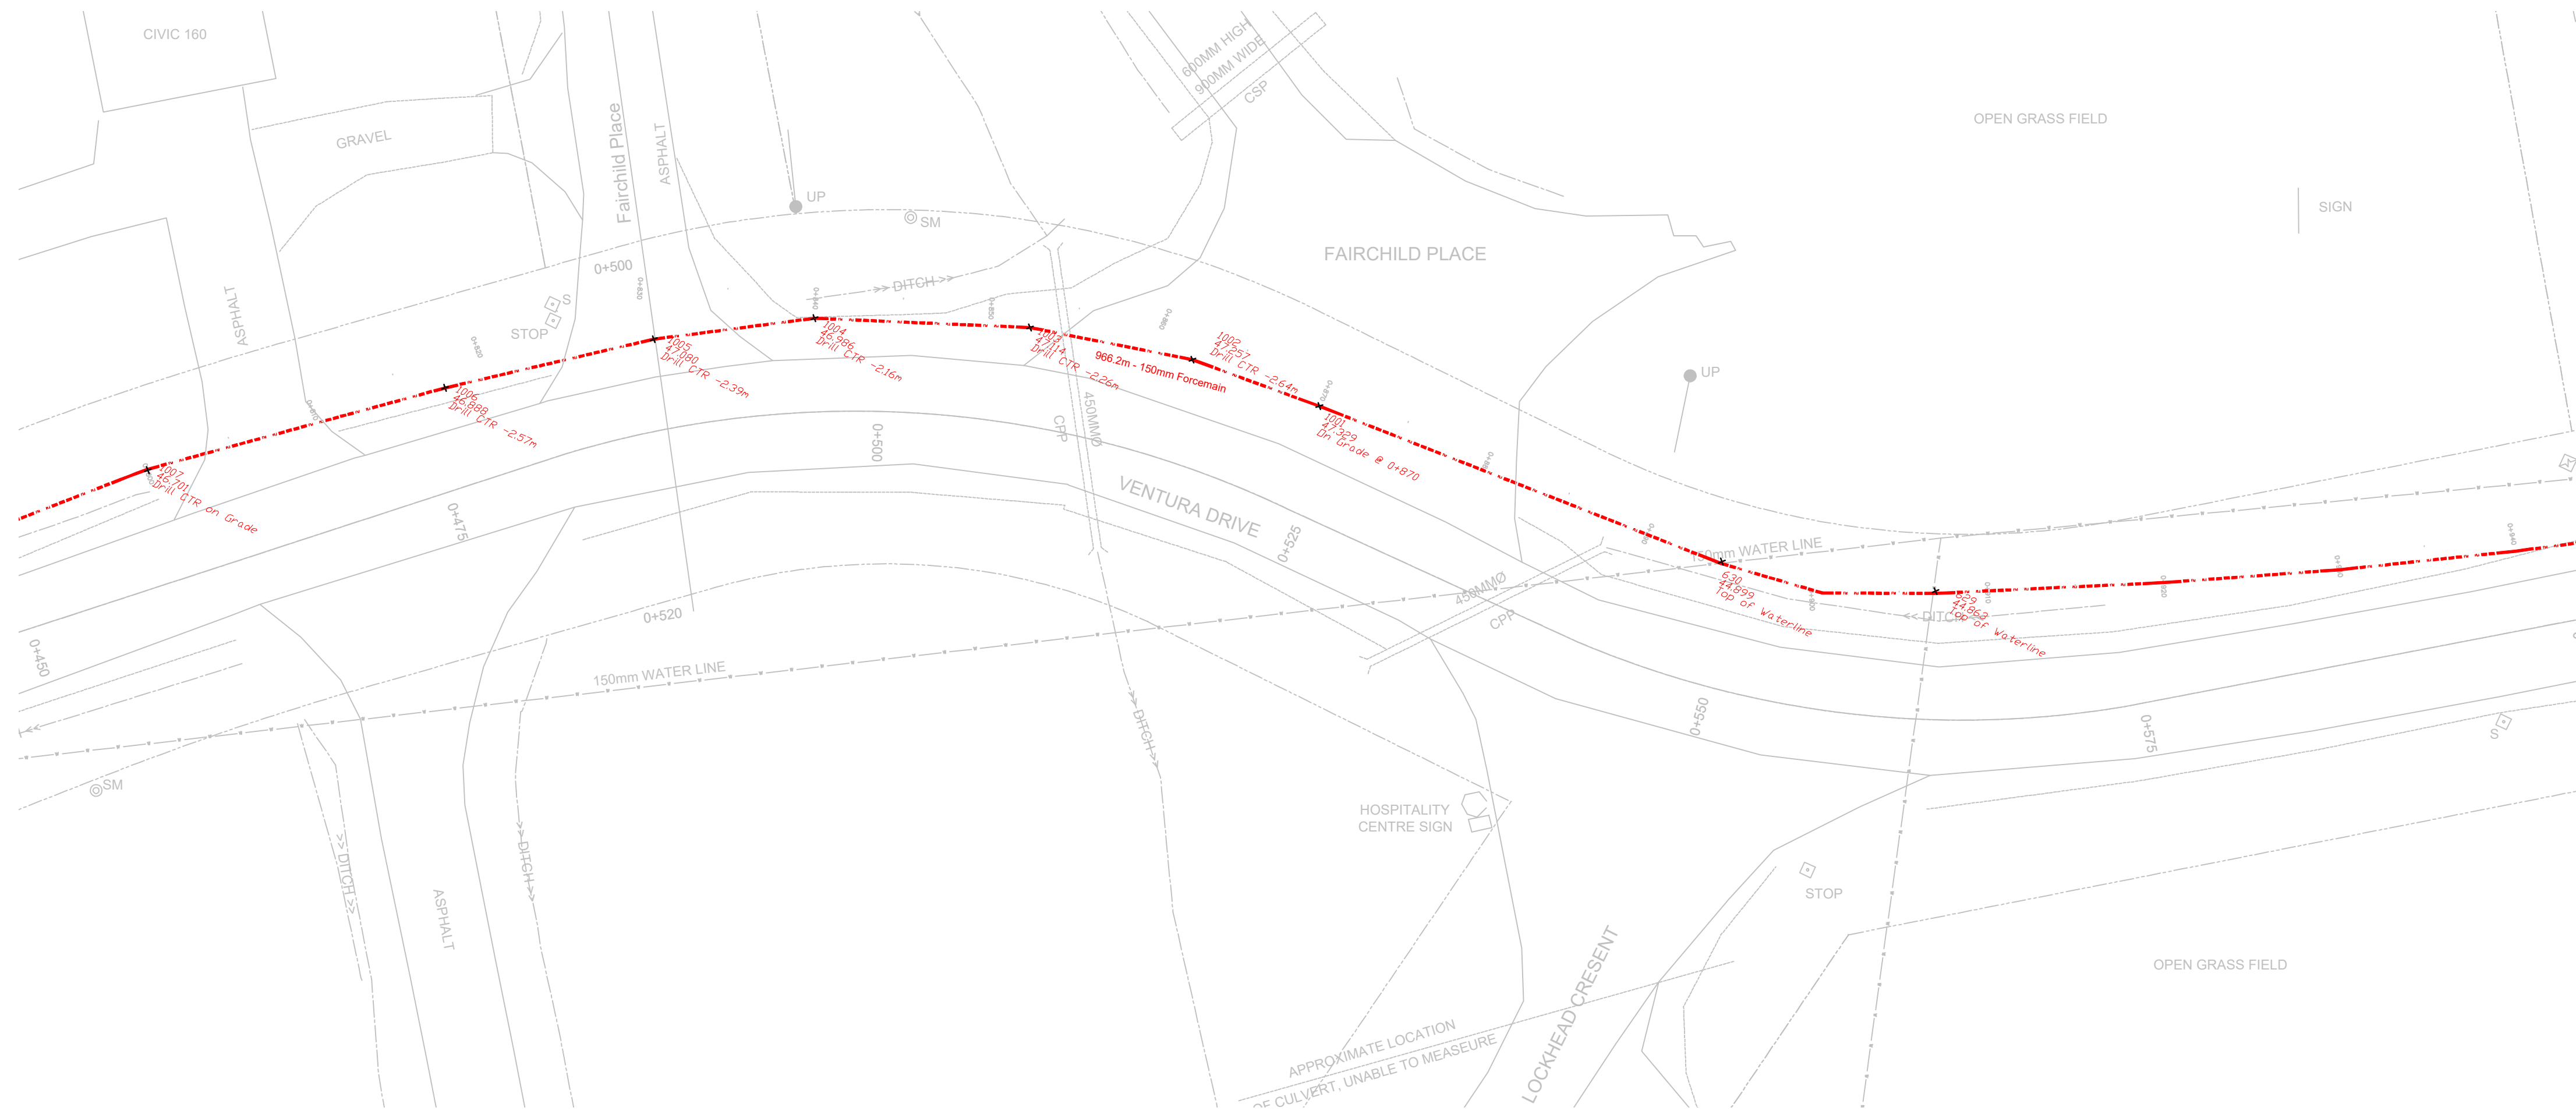

VENTURA DRIVE PLAN - STA. 0+450 TO STA. 0+600

H = 1 : 250

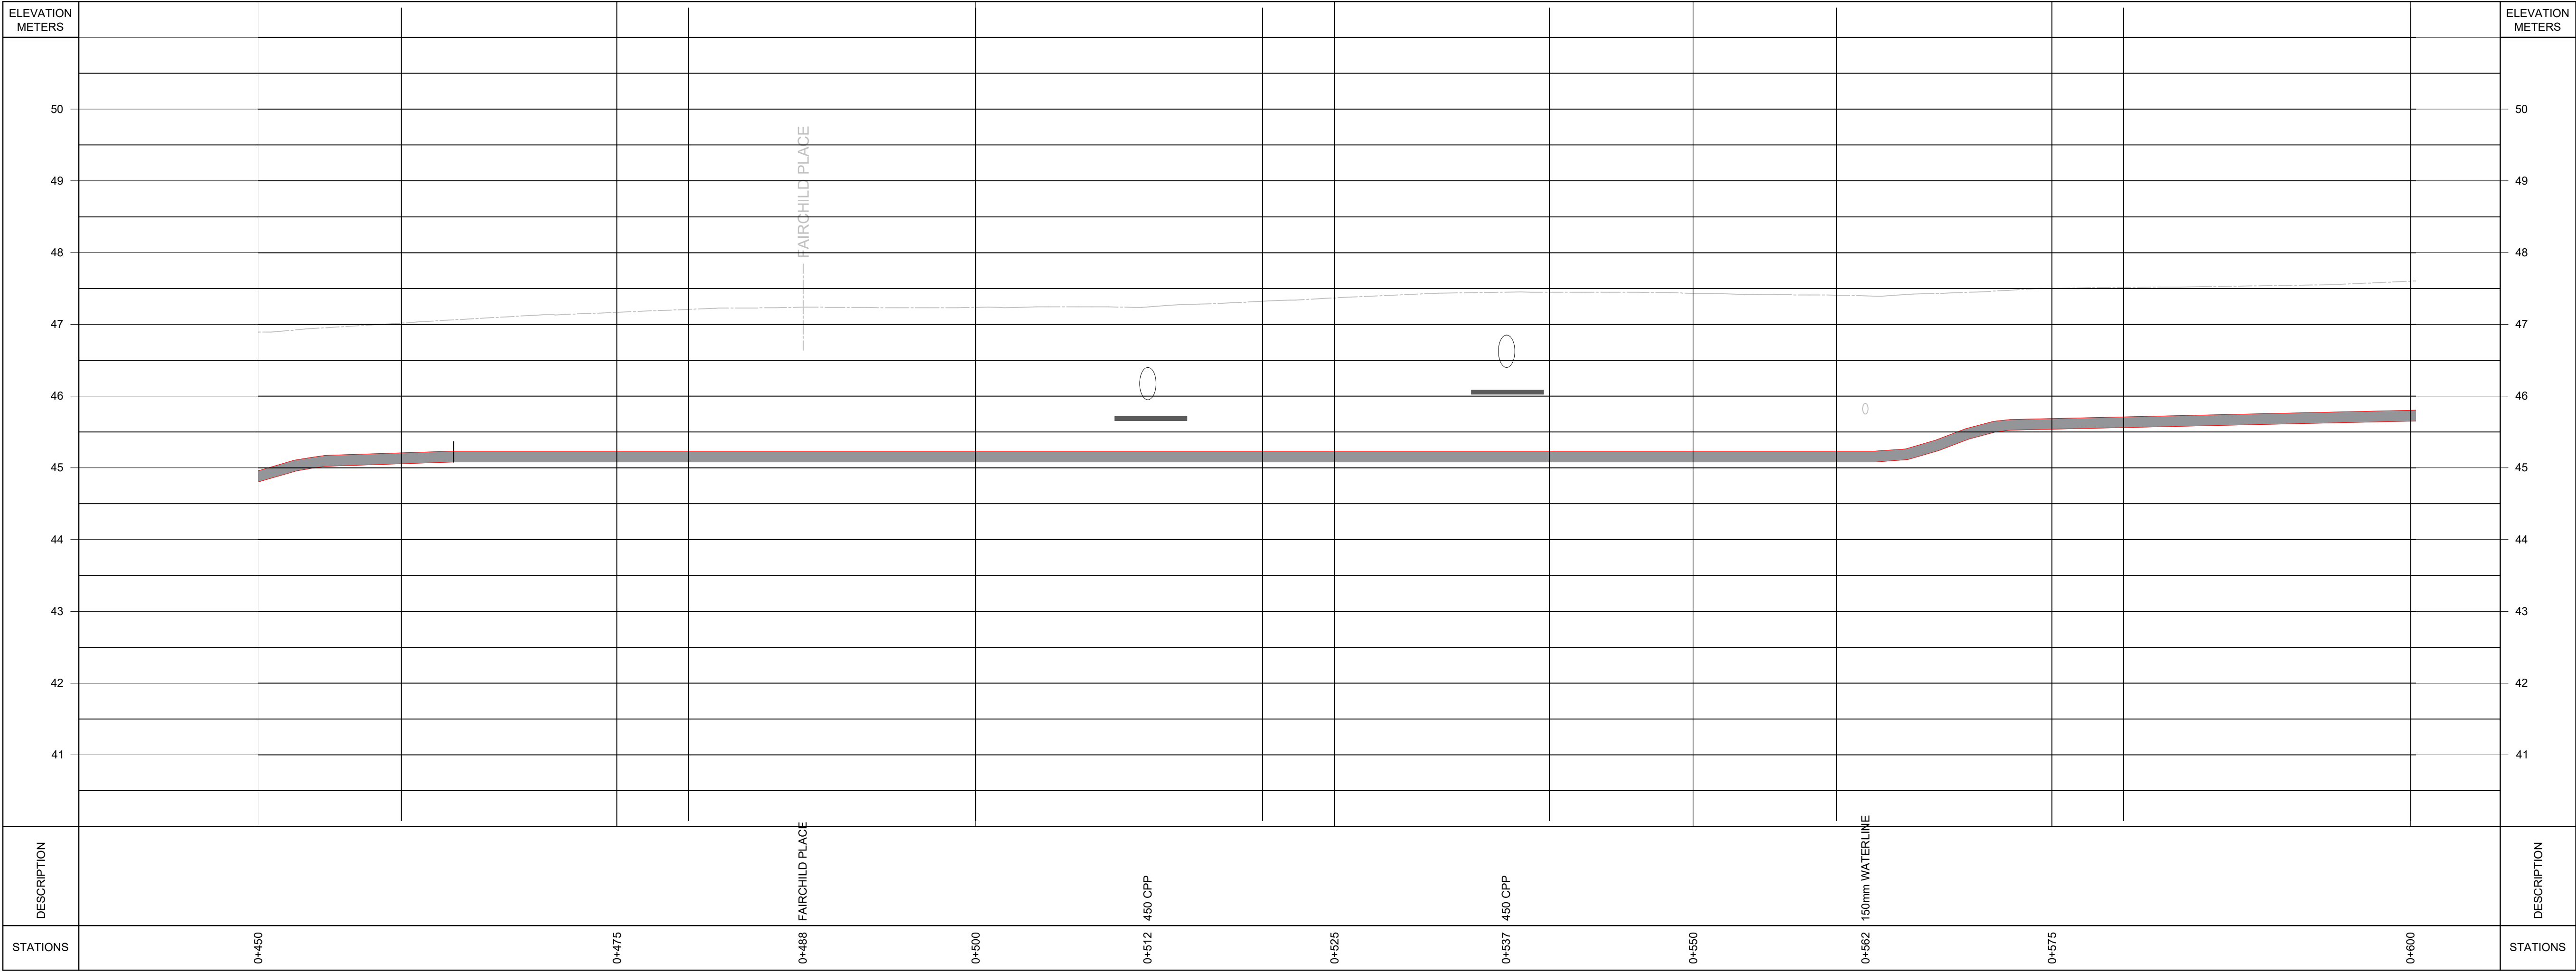

VENTURA DRIVE PROFILE - STA. 0+450 TO STA. 0+600

H = 1 : 250
V = 1 : 50

General Notes

1. SURVEY PLAN PROVIDED BY THOMPSON CONN LIMITED.
- SURVEY CARRIED OUT DECEMBER 6 TO DECEMBER 22, 2021.
2. ALL REFERENCE POINTS ARE REFERRED TO NOVA SCOTIA COORDINATE MONUMENT #209547 ELEV. = 57.223. MAP PROJECTION: NOVA SCOTIA 3' MODIFIED MERCATOR PROJECTION, ZONE 5 (CENTRAL MERIDIAN 64°30'W) DATUM: ATS77. BENCHMARKS HAVE BEEN SET WHERE INDICATED.
3. EXISTING BURIED UTILITIES ARE SHOWN AS APPROXIMATE ONLY. LOCATIONS TO BE FIELD VERIFIED AS NECESSARY BY THE CONTRACTOR.
4. CONTRACTOR SHALL COORDINATE WITH N.S.P. FOR RELOCATION OF UTILITY POLES OR GUYS AS REQUIRED.
5. ALL DISTURBED AREAS MUST BE REINSTATED TO ORIGINAL CONDITION OR BETTER. ROAD ASPHALT TO BE MINIMUM 100mm THICK. PARKING LOT AND DRIVEWAY ASPHALT TO BE MINIMUM 50mm THICK. GRASSED AREAS TO BE REINSTATED WITH TOPSOIL AND SOD.
6. ALL STREET AND TRAFFIC SIGNAGE DISTURBED DURING CONSTRUCTION SHALL BE RESTORED AS SOON AS POSSIBLE AT THE SAME CHAINAGE LOCATION. APPROPRIATE TEMPORARY STREET AND TRAFFIC SIGNAGE SHALL BE MAINTAINED AT ALL LOCATIONS UNTIL SUCH TIME AS THE PERMANENT SIGNAGE IS RESTORED.
7. ANY INFRASTRUCTURE UNCOVERED DURING THE COURSE OF CONSTRUCTION SHALL BE SURVEYED AND INCLUDED IN THE RECORD/AS-BUILT INFORMATION AS PER SPECIFICATIONS.
8. ALL WORK SHALL BE CONSTRUCTED IN ACCORDANCE WITH THE NSDPW STANDARD SPECIFICATION, HIGHWAY CONSTRUCTION AND MAINTENANCE (LATEST EDITION).

1	ISSUED FOR TENDER	MAY 2023
No.	Revision/Issue	Date

MUNICIPALITY OF THE
COUNTY OF COLCHESTER

1 CHURCH STREET, PO BOX 697 TRURO NS B2N 5E7


AS-BUILTS

Project:
DEBERT SEWER - TRACKER & SPS
(PROJECT NO. 2309-1480)

Drawing Title:
VENTURA DRIVE
PLAN & PROFILE
STA. 0+450 TO STA. 0+600


Stamp:	Stamp:

Date:	FEB 2025	Dwg No.:
Drawn/Checked:	TB / CM	C-12
Scale:	AS NOTED	

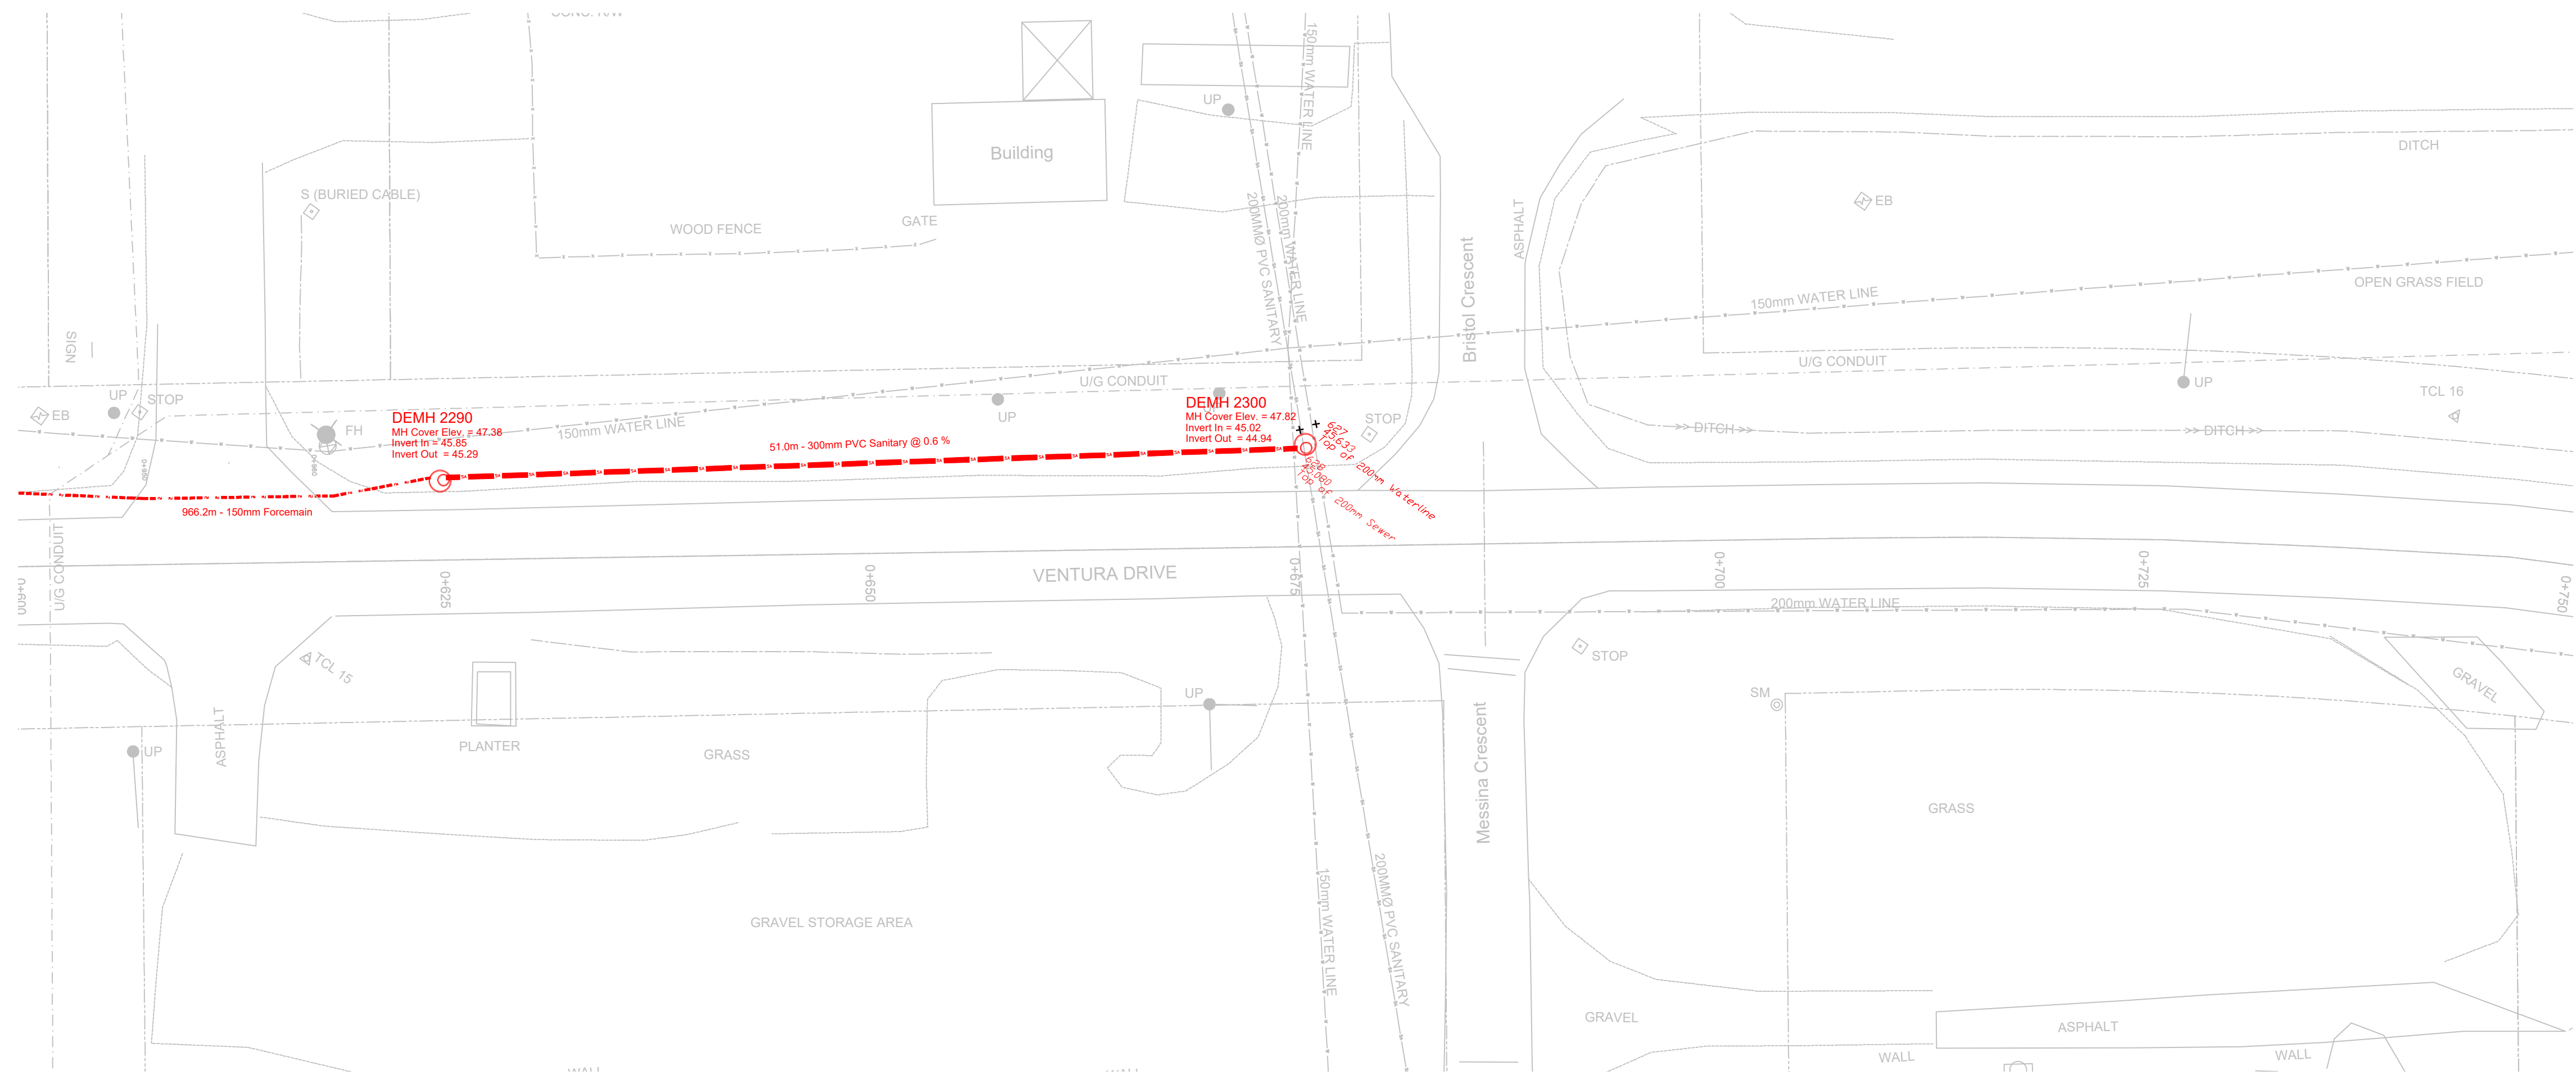


VENTURA DRIVE PLAN - STA. 0+600 TO STA. 0+750

H = 1 : 250

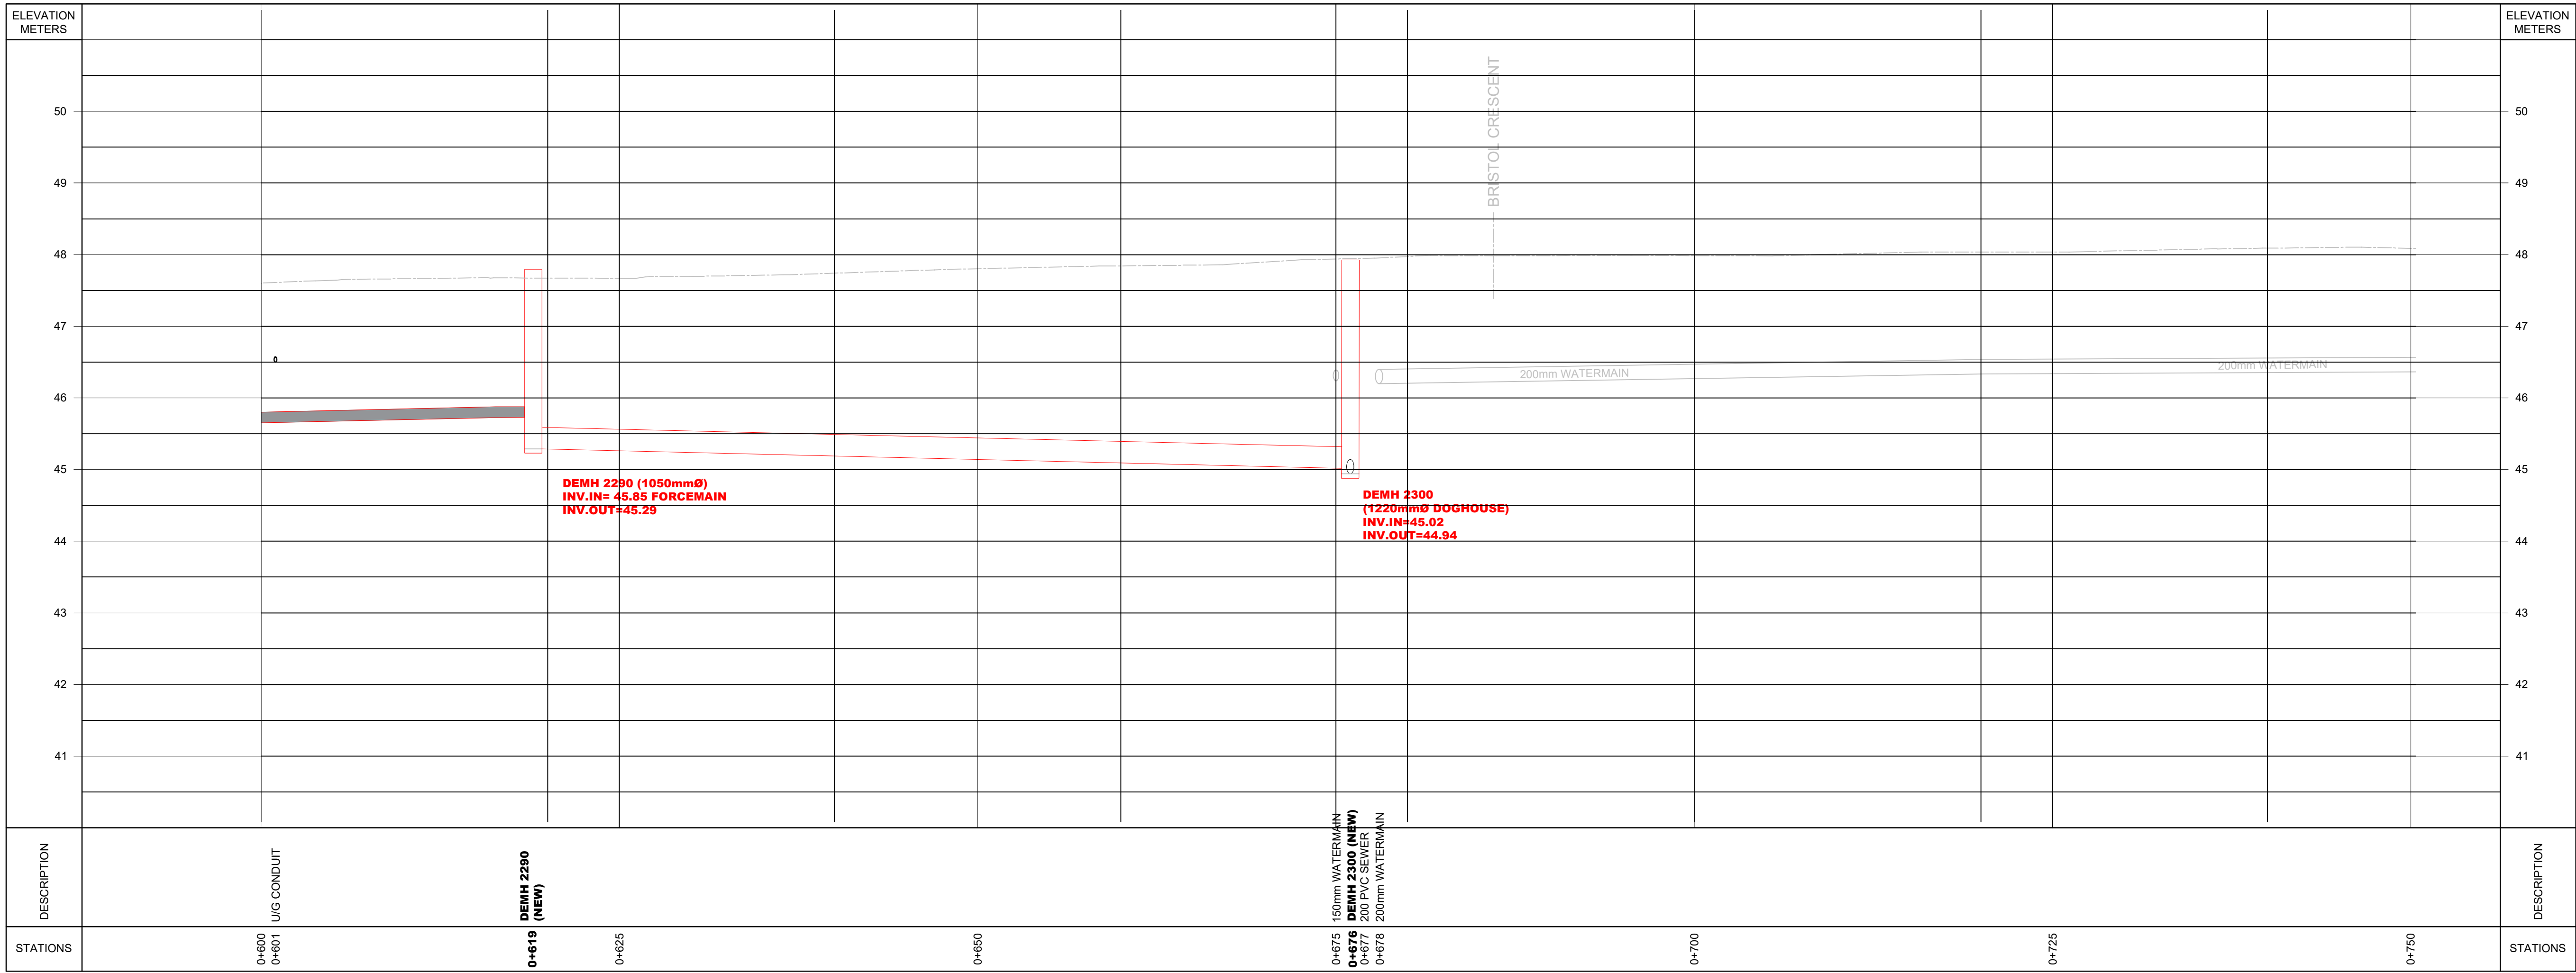

VENTURA DRIVE PROFILE - STA. 0+600 TO STA. 0+750

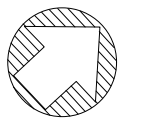

General Notes

1. SURVEY PLAN PROVIDED BY THOMPSON CONN LIMITED.
- SURVEY CARRIED OUT DECEMBER 6 TO DECEMBER 22, 2021.
2. ALL REFERENCE POINTS ARE REFERRED TO NOVA SCOTIA COORDINATE MONUMENT #209547 ELEV. = 57.223. MAP PROJECTION: NOVA SCOTIA 3" MODIFIED MERCATOR PROJECTION, ZONE 5 (CENTRAL MERIDIAN 64°30'W) DATUM: AT377. BENCHMARKS HAVE BEEN SET WHERE INDICATED.
3. EXISTING BURIED UTILITIES ARE SHOWN AS APPROXIMATE ONLY. LOCATIONS TO BE FIELD VERIFIED AS NECESSARY BY THE CONTRACTOR.
4. CONTRACTOR SHALL COORDINATE WITH N.S.P. FOR RELOCATION OF UTILITY POLES OR GUYS AS REQUIRED.
5. ALL DISTURBED AREAS MUST BE REINSTATED TO ORIGINAL CONDITION OR BETTER. ROAD ASPHALT TO BE MINIMUM 100mm THICK. PARKING LOT AND DRIVEWAY ASPHALT TO BE MINIMUM 50mm THICK. GRASSED AREAS TO BE REINSTATED WITH TOPSOIL AND SOD.
6. ALL STREET AND TRAFFIC SIGNAGE DISTURBED DURING CONSTRUCTION SHALL BE RESTORED AS SOON AS POSSIBLE AT THE SAME CHAINAGE LOCATION. APPROPRIATE TEMPORARY STREET AND TRAFFIC SIGNAGE SHALL BE MAINTAINED AT ALL LOCATIONS UNTIL SUCH TIME AS THE PERMANENT SIGNAGE IS RESTORED.
7. ANY INFRASTRUCTURE UNCOVERED DURING THE COURSE OF CONSTRUCTION SHALL BE SURVEYED AND INCLUDED IN THE RECORD/AS-BUILT INFORMATION AS PER SPECIFICATIONS.
8. ALL WORK SHALL BE CONSTRUCTED IN ACCORDANCE WITH THE NSDPW STANDARD SPECIFICATION, HIGHWAY CONSTRUCTION AND MAINTENANCE (LATEST EDITION).

1	ISSUED FOR TENDER	MAY 2023
No.	Revision/Issue	Date

MUNICIPALITY OF THE
COUNTY OF COLCHESTER

1 CHURCH STREET, PO BOX 697 TRURO NS B2N 5E7

AS-BUILTS

Project:
DEBERT SEWER - TRACKER & SPS
(PROJECT NO. 2309-1480)

Drawing Title:
VENTURA DRIVE
PLAN & PROFILE
STA. 0+600 TO STA. 0+750

Stamp:	Stamp:

Date:	FEB 2025	Dwg No.:
Drawn/Checked:	TB / CM	C-13
Scale:	AS NOTED	

H = 1 : 250
V = 1 : 50